

MISSISSIPPI DEPARTMENT OF NATURAL RESOURCES

Bureau of Land and Water Resources

Southport Mall

P.O. Box 10631

Jackson, Mississippi 39209

WATER WELL DRILLERS LOG

CODED

Quitman  
FO15

4  
date well completed

1986 Powell TRR  
firm name

Quitman  
county well located

LANDOWNER:

J. E. Cox

description of formations encountered

from

to

CLAY 0 13  
BROWN CLAY 13 23  
COARSE SAND 23 103  
GRAVEL

MARKS MS  
(mailing address)

WELL LOCATION:

sec. 18 T 28 N R. 1 E  
5 miles NE of MARKS  
(distance) (direction) (nearest town)

WELL PURPOSE: IRRIGATION  
(home, irrigation, municipal, industrial)

WELL COMPLETION DATA:

- (1) diameter (inches) 12
- (2) total depth (feet) 103
- (3) static water level (feet) 14 below top of ground.
- (4) casing 12 63  
(material) (depth)
- (5) screen 40 63  
(length) (depth to top)
- 12 Steel  
(size) (material)
- (6) pump 30 1500  
(HP) (yield gpm)
- diesel  
(type power)
- (7) electric log NO  
(yes or no)


(organization running log)

(8) how well bottom plugged Steel Plate

DRILLERS REMARKS:

86092LHG-02

CODED

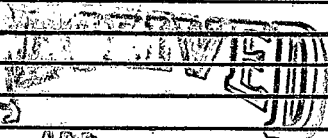

APR - 0 1986

Department of Natural Resources  
Bureau of Land and Water Resources

