

QUITMAN
G-29
5-27-71

MISSISSIPPI
BOARD OF WATER COMMISSIONERS
416 North State Street
Jackson, Mississippi 39201

CODED

WATER WELL DRILLERS LOG

MAY 27 1971 date well completed FIVE COUNTY FARMERS ASSN. firm name QUITMAN county well located

LANDOWNER: OTIS MEREDITH	description of formations encountered	from	to
SABINO, MISS (mailing address)	CLAY	0	14
WELL LOCATION: sec. 29 T. 27 N. R. 2 E. 1 1/2 miles SW of SABINO (distance) (direction) (nearest town)	CLAY	14	20 1/2
WELL PURPOSE: (home, irrigation, municipal, industrial)	CLAY	20 1/2	27
WELL COMPLETION DATA:	CLAY	27	33 1/2
(1) diameter (inches) 6"	CLAY	33 1/2	40
(2) total depth (feet) 118'	CLAY	40	46 1/2
(3) static water level (feet) 15' below top of ground. schedule 40 70' (material) (depth)	CLAY	46 1/2	53
(4) casing (material) (depth)	CLAY	53	59 1/2
6" (size) if telescope see back.	CLAY	59 1/2	66
(5) screen 48' (length) 70' (depth to top)	SAND & GRAVEL	66	72 1/2
6" (size) DOERR (material)	SAND & GRAVEL	72 1/2	79
(6) pump HAYS (HP) 1450 (yield gpm)	SAND & GRAVEL	79	85 1/2
TRACTOR (type power)	SAND & GRAVEL	85 1/2	92
(7) electric log No (yes or no)	SAND & GRAVEL	92	98 1/2
(organization running log)	SAND & GRAVEL	98 1/2	105
(8) how well bottom plugged WELDED	SAND & GRAVEL	105	111 1/2
DRILLERS REMARKS:	SAND & GRAVEL	111 1/2	118


CODED

JUN 11 1971

MISS. BD. OF
WATER COM.

If well telescopes please sketch and show depths.

GROUND LEVEL

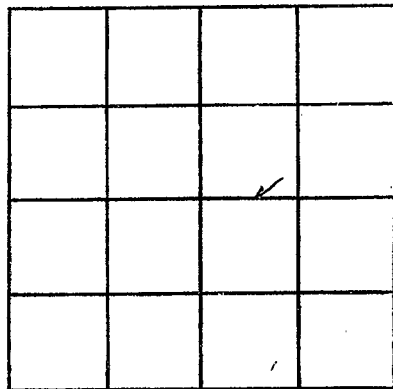

SECTION _____

Please indicate well location X.

ADDITIONAL INFORMATION

If more than one screen, show locations of each on sketch.