

MISSISSIPPI
BOARD OF WATER COMMISSIONERS
416 North State Street
Jackson, Mississippi 39201

CODED

WATER WELL DRILLERS LOG

Quitman

H-18-1967 Quitman County Farmers Assn Quitman
date well completed firm name county well located

LANDOWNER: JT Massey

description of formations
encountered

from to

Massey farmer home
Lyers miss
(mailing address)

Top Soil		14
Clay + Sand streaks	1 1/2	20 1/2
Med Sand	5 1/2	72 1/2
Coarse Sand w/ Rock	45 1/2	118
Clay after 122 ft		125

WELL LOCATION:

sec. 19 T 27 N R 2 E
7 miles East of Charlottesville
(distance) (direction) (nearest town)

WELL PURPOSE: irrigation
(home, irrigation, municipal, industrial)

WELL COMPLETION DATA:


- (1) diameter (inches) 12"
- (2) total depth (feet) 72'
- (3) static water level (feet) 16' ³ below top of ground.
- (4) casing 12" casing 72'
(material) (depth)
- 12" If telescope see back.
(size)
- (5) screen 48' 72'
(length) (depth to top)
- 12" Dann Screen
(size) (material)
- (6) pump 30 1900
(HP) (yield gpm)
- Tractor
(type power)
- (7) electric log NO
(yes or no)

(organization running log)

(8) how well bottom plugged Welded


DRILLERS REMARKS:

CODED

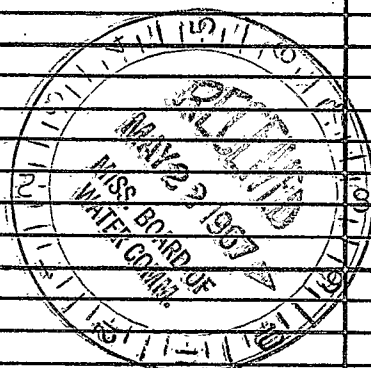

If well telescopes please
sketch and show depths.

GROUND LEVEL

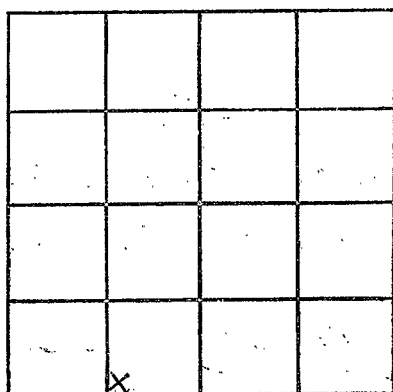

SECTION 19

Please indicate well location X.

ADDITIONAL INFORMATION

If more than one screen,
show locations of each on sketch.