

Quitman
G40
4-68

MISSISSIPPI
BOARD OF WATER COMMISSIONERS
416 North State Street
Jackson, Mississippi 39201

CODED

WATER WELL DRILLERS LOG

Apr. 25 1968 date well completed
68 JEFFERSON COUNTY Farmers BSSN firm name
Quitman county well located

LANDOWNER: O.F. Meredith

PT-1 Box 22
Lambert Miss
(mailing address)

WELL LOCATION:

sec. 29 T. 26 N R. 2 W
2 1/2 miles SW of Sabine
(distance) (direction) (nearest town)

WELL PURPOSE: Irrigation
(home, irrigation, municipal, industrial)

WELL COMPLETION DATA:

- (1) diameter (inches) 6
- (2) total depth (feet) 119
- (3) static water level (feet) 15.2 below top of ground.
- (4) casing Pipe, 71' (material), (depth)
6" (size) if telescope see back.
- (5) screen 48' 71' (length), (depth to top)
6" (size), Pipe (material)
- (6) pump 10 (HP) 1000 (yield gpm)
(type power)
- (7) electric log (yes or no)
- (organization running log)
- (8) how well bottom plugged Welded

description of formations encountered	from	to
TOP SOIL Breakshot		14
clay		53
fine Sand		59 1/2
Med Sand		70
Clay		74
Coarse Sand + Gravel		125

CODED


MAY 1 1968

MISS. BD. OF COMM.

DRILLERS REMARKS:

If well telescopes please
sketch and show depths.

GROUND LEVEL

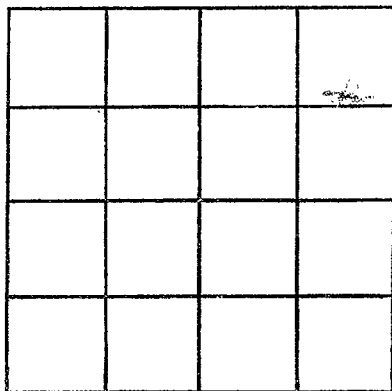

SECTION _____

Please indicate well location X.

ADDITIONAL INFORMATION

If more than one screen,
show locations of each on sketch.