

Quitman

MISSISSIPPI BOARD OF WATER COMMISSIONERS

G 38 42

7-66

WATER WELL DRILLERS LOG

**CODED**

Quitman

Date: 7-25, 1966, Driller: Fiddon & Jones County Quitman

(Name)

(1) Owner of Land: Bob Carson  
(Name)

Buckskin Pk. Lambert  
(Address)

(2) Location: NE 1/4, SW 1/4, Sec. 35 T14 R11 W1  
3 miles NE of Bellevue  
(distance) (direction) (Nearest Town)

(3) Topography: Flat  
(Hilly) (Flat) (Level)

(4) Purpose of Well: Irrigation  
(Domestic Irrigation, Municipal, Industrial, Other)

Description & Color of Materials Sand, Clay, Red Clay, Shell, etc.	Thick- ness Feet	Depth Feet
<u>Clay + Topsoil</u>		<u>46 1/2</u>
<u>Sand</u>	<u>19 1/2</u>	<u>66</u>
<u>Sand + Gravel</u>	<u>26</u>	<u>92</u>
<u>Wood + Gravel - Some Sand</u>	<u>13</u>	<u>105</u>
<u>Sand + Gravel</u>	<u>16 1/2</u>	<u>121 1/2</u>
<u>SOLID Rock -</u>		

Information upon completion of well:

(1) Diameter 6 inches.

(2) Total Depth 116 feet.

(3) Water Level 15' 7" feet below top of ground.

(4) Cased to 68', Size 6"

(5) Screen: Size 6", Length 48'


(6) Were any formations sealed against pollution?  
yes, no.

If YES depth of formation \_\_\_\_\_

Why \_\_\_\_\_

Drillers Remarks: \_\_\_\_\_

**CODED**

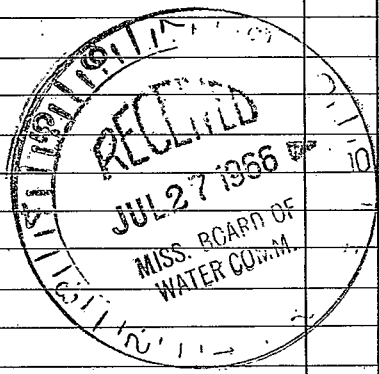

Well No.

(Use Back Side)

