

QUITMAN
 G 43
 4-10-78

MISSISSIPPI
 BOARD OF WATER COMMISSIONERS
 416 North State Street
 Jackson, Mississippi 39201

CODED

WATER WELL DRILLERS LOG

4-10 1978 Fine Co. Farm. Mem Quitman
 date well completed firm name county well located

LANDOWNER: B. A. Carson
Lambert miss
 (mailing address)
 WELL LOCATION:
 sec. 35 T. 27 N. R. 2 E. S. W
3 1/2 miles S-W of Lambert
 (distance) (direction) (nearest town)

WELL PURPOSE: drinking
 (home, irrigation, municipal, industrial)

WELL COMPLETION DATA:
 (1) diameter (inches) 8"
 (2) total depth (feet) 120
 (3) static water level (feet) 12 below above top of ground.
 (4) casing PVC 80
 (material) (depth)
 (size) if telescope see back.
 (5) screen 40' 80
 (length) (depth to top)
8" PVC
 (size) (material)
 (6) pump Relift 1200
 (HP) (yield gpm)
Diesel
 (type power)
 (7) electric log NO
 (yes or no)
 (organization running log)
 (8) how well bottom plugged cap

description of formations encountered	from	to
<u>Top Clay</u>	<u>0</u>	<u>10</u>
<u>fine sand</u>	<u>10</u>	<u>30</u>
<u>Coarse sand</u>	<u>30</u>	<u>55</u>
<u>sand & pe. sh.</u> CODED	<u>55</u>	<u>85</u>
<u>sand & lra</u>	<u>85</u>	<u>120</u>


DRILLERS REMARKS:

RECEIVED
 MAY 8 - 1978

MISS. Bd. OF WATER COMMISSIONERS

If well telescopes please sketch and show depths.

GROUND LEVEL

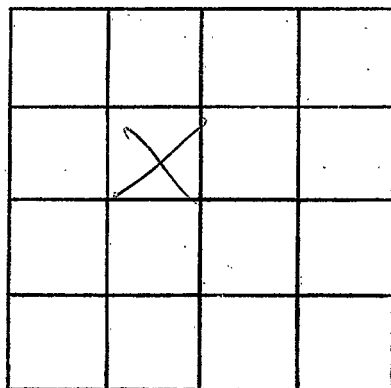

SECTION _____

Please indicate well location X.

ADDITIONAL INFORMATION

If more than one screen,
show locations of each on sketch.