

QUITMAN  
 E 44  
 3-8-78

MISSISSIPPI  
 BOARD OF WATER COMMISSIONERS  
 416 North State Street  
 Jackson, Mississippi 39201

CODED

WATER WELL DRILLERS LOG

3-8 1978 Five Co. Farms Area Quitman  
 date well completed firm name county well located

LANDOWNER: Rt. Coover  
Lambert min  
 (mailing address)

description of formations encountered	from	to
<u>top clay</u>	<u>0</u>	<u>10</u>
<u>fine sand</u>	<u>10</u>	<u>110</u>
<u>Coover sand</u>	<u>110</u>	<u>65</u>
<u>sand &amp; gravel</u>	<u>65</u>	<u>180</u>

CODED

WELL LOCATION:  
 sec. 36 T 27 N R 2 E  
S E  
3 miles S.W. of Lambert  
 (distance) (direction) (nearest town)

WELL PURPOSE: irrigation  
 (home, irrigation, municipal, industrial)

- WELL COMPLETION DATA:
- diameter (inches) 8"
  - total depth (feet) 120
  - static water level (feet) 13 below above top of ground.
  - casing PVC 80  
 (material) (depth)  
 (size) if telescope see back.
  - screen 40' 80  
 (length) (depth to top)  
8" PVC 50 slot  
 (size) (material)
  - pump 30 1200  
 (HP) (yield gpm)  
direct  
 (type power)
  - electric log no  
 (yes or no)  
 (organization running log)
  - how well bottom plugged cap


DRILLERS REMARKS:

RECEIVED  
 MAY 8 - 1978

MISS. BD. OF WATER COMM

If well telescopes please sketch and show depths.

GROUND LEVEL

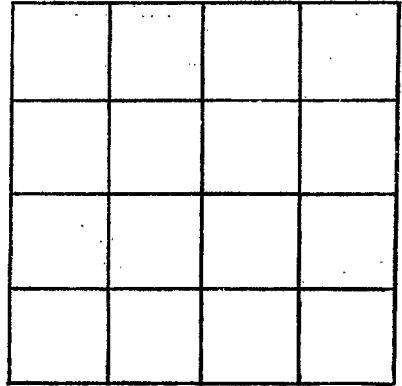

SECTION \_\_\_\_\_

Please indicate well location X.

ADDITIONAL INFORMATION

If more than one screen, show locations of each on sketch.