

QUITMAN
 645
 4-2-78

MISSISSIPPI
 BOARD OF WATER COMMISSIONERS
 416 North State Street
 Jackson, Mississippi 39201

CODED

WATER WELL DRILLERS LOG

2 1978 Five Co. Farmers Union Quitman
 date well completed firm name county well located

LANDOWNER: <u>Danny Bayley</u> <u>Lambert Miss</u>	description of formations encountered	from	to
(mailing address)	<u>top clay</u>	0	12
WELL LOCATION: sec. <u>25</u> T. <u>27</u> (N) S R. <u>2</u> E (W)	<u>fine sand</u>	17	30
<u>4.5</u> miles <u>west</u> of <u>Lambert</u> (distance) (direction) (nearest town)	<u>Coarse sand</u>	30	60
WELL PURPOSE: <u>irrigation</u> (home, irrigation, municipal, industrial)	<u>sand & pea</u>	60	80
WELL COMPLETION DATA: (1) diameter (inches) <u>10"</u>	<u>pea</u>	80	110
(2) total depth (feet) <u>110</u>			
(3) static water level (feet) <u>14</u> <u>below</u> top of ground.			
(4) casing <u>70 PVC</u> , <u>70</u> (material) (depth) ____ if telescope see back. (size)			
(5) screen <u>40'</u> , <u>70</u> (length) (depth to top) <u>10</u> , <u>PVC 50 S10T</u> (size) (material)			
(6) pump _____ (HP) (yield gpm) _____ (type power)			
(7) electric log _____ (yes or no) _____ (organization running log)			
(8) how well bottom plugged <u>Cap</u>			
DRILLERS REMARKS:			


CODED

RECEIVED
 MAY 8 - 1978

MISS. BD. OF WATER COMMISSIONERS

If well telescopes please sketch and show depths.

GROUND LEVEL

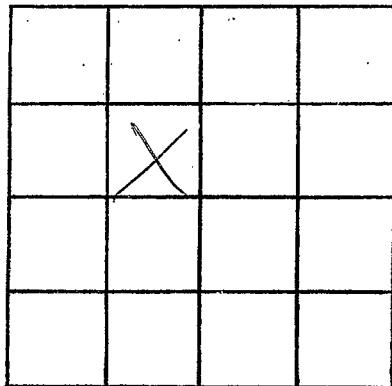

SECTION 25

Please indicate well location X.

ADDITIONAL INFORMATION

If more than one screen,
show locations of each on sketch.