

QUITMAN
 G 47
 4-3-78

MISSISSIPPI
 BOARD OF WATER COMMISSIONERS
 416 North State Street
 Jackson, Mississippi 39201

CODED

WATER WELL DRILLERS LOG

4-3 1978 Five Co Farmer Ass Quitman
 date well completed firm name county well located

LANDOWNER: <u>Danny Bailey</u> <u>Lambert Miss</u>	description of formations encountered	from	to
	<u>top clay</u>	0	8
	<u>fine sand</u>	8	35
	<u>course sand</u>	35	70
	<u>sand & silt</u>	70	112

(mailing address)

WELL LOCATION:
 sec. 23 T. 27 N. R. 2 E. S. 5 W. 4
 (distance) miles (direction) of (nearest town)

WELL PURPOSE: irrigation
 (home, irrigation, municipal, industrial)

CODED

- WELL COMPLETION DATA:
- (1) diameter (inches) 10"
 - (2) total depth (feet) 112
 - (3) static water level (feet) 14 below above top of ground.
 - (4) casing PVC (material), 72 (depth),
 (size) if telescope see back.
 - (5) screen 40' (length), 72 (depth to top)
10' (size), PVC 50 SLOT (material)
 - (6) pump _____ (HP) _____ (yield gpm)
 (type power)
 - (7) electric log NO (yes or no)
 (organization running log)
 - (8) how well bottom plugged Cap


DRILLERS REMARKS:

RECEIVED
 MAY 8 - 1978

MISS. BD. OF WATER COMM.

If well telescopes please sketch and show depths.

GROUND LEVEL

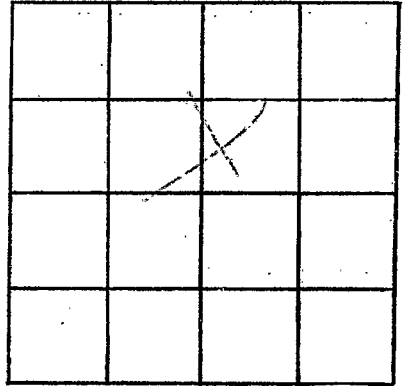

SECTION 3023

Please indicate well location X.

ADDITIONAL INFORMATION

If more than one screen,
show locations of each on sketch.