

MISSISSIPPI DEPARTMENT OF NATURAL RESOURCES
 Bureau of Land and Water Resources
 Southport Mall
 P.O. Box 10631
 Jackson, Mississippi 39209
WATER WELL DRILLERS LOG

CODED

QUITMAN
1549
11/25/81

11-25-1981 *N. Delta Drilling Co.* *Quitman*
 date well completed firm name county well located

LANDOWNER: <i>Carmon Farms</i>	description of formations encountered	from	to
<i>Rt. 1st Box 80</i>			
<i>MARKS MS</i> (mailing address)	<i>Clay</i> <i>fine sand</i> <i>Coarse sand</i>	<i>0</i> <i>22</i> <i>51</i>	<i>22</i> <i>51</i> <i>97</i>
WELL LOCATION:			
sec <i>7</i> T <i>27</i> N R <i>2</i> E S W			
<i>12</i> miles <i>East</i> of <i>Clarksdale</i> (distance) (direction) (nearest town)			
WELL PURPOSE: <i>Irrigation</i> (home, irrigation, municipal, industrial)			
WELL COMPLETION DATA:			
(1) diameter (inches) <i>12"</i>			
(2) total depth (feet) <i>97</i>			
(3) static water level (feet) <i>17</i> - below top of ground.			
(4) casing <i>12"</i> <i>57'</i> (material) (depth) <i>12"</i> If telescope see back. (size)			
(5) screen <i>40'</i> <i>57'</i> (length) (depth to top)			
<i>12</i> <i>STEEL</i> (size) (material)			
(6) pump <i>60</i> <i>1350</i> (HP) (yield gpm)			
<i>Diesel</i> (type power)			
(7) electric log <i>NO</i> (yes or no)			
(organization running log)			
(8) how well bottom plugged <i>Plugs</i>			
DRILLERS REMARKS:			


CODED

DEPT. OF NATURAL RESOURCES
 BUREAU OF LAND & WATER RESOURCES

DEC 10 1981
RECEIVED

If well telescopes please sketch and show depths.

GROUND LEVEL

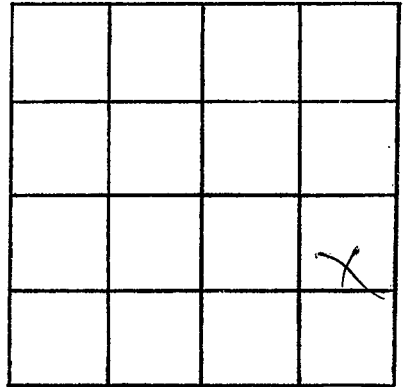

SECTION 21

Please indicate well location X.

ADDITIONAL INFORMATION

If more than one screen, show locations of each on sketch.