

MISSISSIPPI DEPARTMENT OF NATURAL RESOURCES

Bureau of Land and Water Resources

Southport Mall

P.O. Box 10631

Jackson, Mississippi 39209

WATER WELL DRILLERS LOG **CODED**

QUITMAN
1550
11/17/81

11-17 1981 N. Delta Drilling Co. Quitman
 date well completed firm name county well located

LANDOWNER: Gannon Farms
RT 1 Box 80
Mark's ms 38646
 (mailing address)

description of formations encountered	from	to
<u>clay</u>	<u>0</u>	<u>12</u>
<u>fine sand</u>	<u>12</u>	<u>55</u>
<u>Coarse sand gravel</u>	<u>55</u>	<u>103</u>

WELL LOCATION:
 sec 21 T 27 S R 2 E
12 miles East of Jackalva
 (distance) (direction) (nearest town)

WELL PURPOSE: Domestic
 (home, irrigation, municipal, industrial)

- WELL COMPLETION DATA:
- (1) diameter (inches) 12"
 - (2) total depth (feet) 103
 - (3) static water level (feet) 18 below top of ground.
 - (4) casing: STEEL, 63
 (material) (depth)
12 (size) If telescope see back.
 - (5) screen 40', 63'
 (length) (depth to top)
12", STEEL
 (size) (material)
 - (6) pump 100, 1350
 (HP) (yield gpm)
DIMSAI
 (type power)
 - (7) electric log NO
 (yes or no)
NO
 (organization running log)
 - (8) how well bottom plugged Plugged

CODED

DEPT. OF NATURAL RESOURCES
 BUREAU OF LAND & WATER RESOURCES


DEC 10 1981

RECEIVED

DRILLERS REMARKS:

If well telescopes please sketch and show depths.

GROUND LEVEL

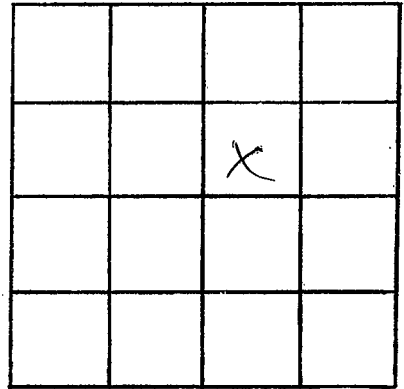

SECTION 21

Please indicate well location X.

ADDITIONAL INFORMATION

If more than one screen, show locations of each on sketch.