

Quitman

CL-2108 **652**

6-9-82

MISSISSIPPI DEPARTMENT OF NATURAL RESOURCES

Bureau of Land and Water Resources

Southport Mall

P.O. Box 10631

Jackson, Mississippi 39209

WATER WELL DRILLERS LOG

CODED

6-9 1982
date well completed

LAYNE-CENTRAL CO.
firm name

QUITMAN
county well located

LANDOWNER: Barksdale Farm
c/o Circle "S" IRRIGATION
CLARKSDALE, MS

(mailing address)

description of formations encountered

from to

clay	0	18
fine sand	18	47
c. sand	47	65
c. sand & pea gravel	65	85
c. sand & gravel	85	98
c. sand & pea gravel	98	123

#2 WELL LOCATION:

sec. 9 T 27 N R 2 W
2 miles N of Sabino
(distance) (direction) (nearest town)

WELL PURPOSE: irrigation
(home, irrigation, municipal, industrial)

WELL COMPLETION DATA:

- (1) diameter (inches) 28"
- (2) total depth (feet) 123'
- (3) static water level (feet) 20' below top of ground.
- (4) casing steel 83' (material), (depth)
12" (size) if telescope see back.
- (5) screen 40' 83' (length), (depth to top)
12" st. steel (size), (material)
- (6) pump 80 1400 (HP), (yield gpm)
gear drive (type power)
- (7) electric log no (yes or no)
(organization running log)
- (8) how well bottom plugged st. plate

DRILLERS REMARKS:


DEPT. OF NATURAL RESOURCES
BUREAU OF LAND & WATER RESOURCES

SEP - 9 1982

RECEIVED

If well telescopes please sketch and show depths.

GROUND LEVEL

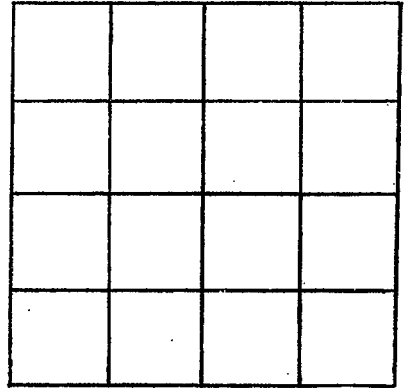

SECTION _____

Please indicate well location X.

ADDITIONAL INFORMATION

If more than one screen,
show locations of each on sketch.