

**Quitman**  
 CL-2108 **G 5 B**  
**6-8-82**

**MISSISSIPPI DEPARTMENT OF NATURAL RESOURCES**  
 Bureau of Land and Water Resources  
 Southport Mall  
 P.O. Box 10631  
 Jackson, Mississippi 39209 **CODED**  
**WATER WELL DRILLERS LOG**

6-8 19 82 Layne-Central Co. Quitman  
 date well completed firm name county well located

**LANDOWNER:** Barksdale Farms  
 c/o Circle "S" Irrigation  
 Clarksdale, MS  
 (mailing address)

description of formations encountered	from	to
clay	0	20
fine sand	20	46
coarse sand	46	59
c.sand & pea gravel	59	84
c.sandy gravel	84	103
c.sand & pea gravel	103	117

**WELL LOCATION:**  
 sec. 9 T 27 N R. 2 W  
 2 miles N of Sabino  
 (distance) (direction) (nearest town)

**WELL PURPOSE:** irrigation  
 (home, irrigation, municipal, industrial)

**WELL COMPLETION DATA:**

(1) diameter (inches) 28"

(2) total depth (feet) 117'

(3) static water level (feet) 16' below top of ground.

(4) casing steel 77'  
 (material) (depth)  
 12" If telescope see back.  
 (size)

(5) screen 40' 77'  
 (length) (depth to top)  
 12" st. steel  
 (size) (material)

(6) pump 80 1400  
 (HP) (yield gpm)  
 gear drive  
 (type power)

(7) electric log no  
 (yes or no)  
 (organization running log)

(8) how well bottom plugged st. plate

**DRILLERS REMARKS:**


DEPT. OF NATURAL RESOURCES  
 BUREAU OF LAND & WATER RESOURCES

SEP - 9 1982

**RECEIVED**

If well telescopes please sketch and show depths.

GROUND LEVEL

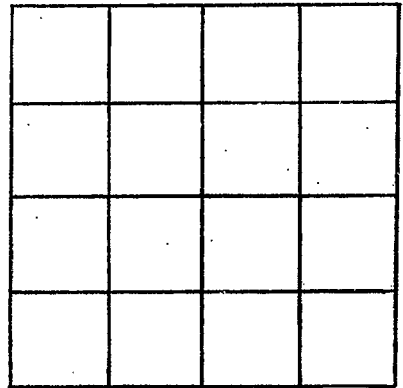

SECTION \_\_\_\_\_

Please indicate well location X.

ADDITIONAL INFORMATION

If more than one screen,  
show locations of each on sketch.