

MISSISSIPPI DEPARTMENT OF NATURAL RESOURCES

Bureau of Land and Water Resources

P.O. Box 10631

Jackson, Mississippi 39209

WATER WELL DRILLERS LOG

COUNTY WELL LOCATED
Quitman

WELL NUMBER G 56 CODED

DATE WELL COMPLETED 3/22/88

PERMIT NUMBER 08827-CME-06788

NAME OF DRILLING FIRM Five Co

88A

NAME & MAILING ADDRESS OF LANDOWNER
John Soney

WELL LOCATION: SEC NWSE TOWNSHIP S RANGE T27

DISTANCE 7 Miles WEST of MARKS

NEAREST TOWN MARKS

OTHER LANDMARK _____

WELL PURPOSE: Home, Irrigation, Municipal, Industrial, Fish Pond, etc.

PUMP DATA

PUMP TYPE (Circle One):
Submersible, Turbine, Jet, Flowing Well, Other (Describe) _____

POWER TYPE (Circle One):
Electric, Tractor, Diesel, Gasoline, Butane, Other (Describe) _____

Pump Capacity (GPM)	No. of Stages	Setting Depth
<u>1800</u>	<u>2</u>	<u>50'</u> FT.

PUMP TEST

Well yielded _____ GPM with a drawdown of _____ ft. after _____ hours of pumping

WELL DATA

Well Depth <u>100'</u>	Casing Diameter (In.) <u>16"</u>	Casing Length (Ft.) <u>60'</u>
Type of Casing <u>Steel</u>	Hole Depth <u>100'</u>	Depth to Static Water Level <u>18.6</u>

TYPE OF COMPLETION: (Circle One or More):
Gravel Packed, Underreamed, Telescoped, Natural Development, Open Hole, Other (Describe) _____

Top of Lap Pipe or Reduction in Casing _____ FEET

IF TELESCOPED OR MORE THAN ONE SCREEN: USE BACK PAGE

LOG DATA

TYPE OF LOG RUN (Circle One):
No Log Run, Electric, Gamma Ray, Density, Sonic, Neutron, Other (Describe) _____

Name of Organization Running Log _____

SCREEN DATA

Diameter - Inches <u>16"</u>	Length - Feet <u>40'</u>	Slot Size - Inches <u>1030</u>
Screen Type <u>Steel</u>	Depth to Bottom - Feet <u>100'</u>	

GEOLOGIC DATA (Office Use Only)

Surface Elev.	Geologic Unit	Unit Thickness	Depth to Top
Subs. SWL	Date	Analysis	Aquifer Test

Driller's Remarks

DESCRIPTION OF FORMATIONS ENCOUNTERED	FROM	TO
<u>Top soil</u>	<u>0</u>	<u>8</u>
<u>Med</u>	<u>8</u>	<u>17</u>
<u>fine sand</u>	<u>17</u>	<u>42</u>
<u>Coarse sand</u>	<u>42</u>	<u>56</u>
<u>sand & gra</u>	<u>56</u>	<u>100</u>

FORMATIONS (Continued)

FROM	TO

RECEIVED


MAR 31 1988

Department of Natural Resources
Bureau of Land & Water Resources

IF MORE SPACE IS NEEDED, USE BACK

If well telescopes please
sketch and show depths.

GROUND LEVEL

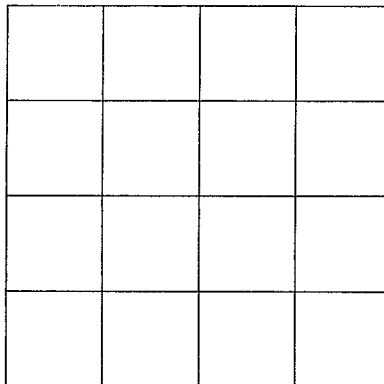

SECTION _____

Please indicate well location X.

ADDITIONAL INFORMATION

If more than one screen,
show location of each on sketch.