

QUITMAN
G 122

MISSISSIPPI
BOARD OF WATER COMMISSIONERS
416 North State Street
Jackson, Mississippi 39201

CODED

WATER WELL DRILLERS LOG

8/20
date well completed

1986 Fin & Form
firm name

Quitman
county well located

LANDOWNER:

J. Z. Murray
Clarksdale
(mailing address)

description of formations encountered

from to

top soil	0	15
fine sand	15	32
med sand	32	48
clay	48	54
coarse sand	54	78
clay	78	80
hard grey	80	105
clay	106	

WELL LOCATION:

sec. 9 T. 27 N. R. 2 E. W
Edalomite miles East of Edal
(distance) (direction) (nearest town)

WELL PURPOSE:

(home, irrigation, municipal, industrial)

WELL COMPLETION DATA:

- diameter (inches) 16"
- total depth (feet) 105
- static water level (feet) 24 below top of ground.
- casing steel, 55 (material), (depth)
16 (size) if telescope see back.
- screen 30', 55 (length), (depth to top)
16", steel (size), (material)
- pump 60 (HP), 2600 (yield gpm)
deural (type power)
- electric log no (yes or no)

(organization running log)

- how well bottom plugged welded

DRILLERS REMARKS:


CODED

RECEIVED
SEP 22 1986

Department of Natural Resources
Bureau of Land & Water Resources

If well telescopes please sketch and show depths.

GROUND LEVEL

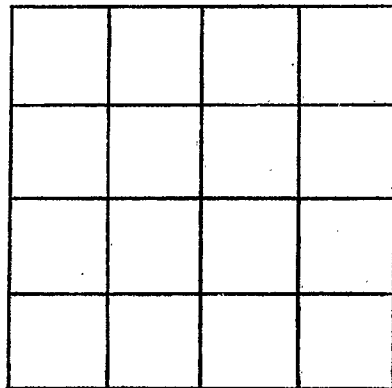

SECTION _____

Please indicate well location X.

ADDITIONAL INFORMATION

If more than one screen,
show locations of each on sketch.