

MISSISSIPPI DEPARTMENT OF NATURAL RESOURCES

Bureau of Land and Water Resources

Southport Mall

P.O. Box 10631

Jackson, Mississippi 39209

WATER WELL DRILLERS LOG

CODED

Quitman  
G 124

19 1987 Powell Irrigation, Inc Quitman  
date well completed firm name county well located

LANDOWNER: Meredith Bros  
Clarksdale MS 38614  
(mailing address)

description of formations encountered	from	to
<u>Clay</u>	<u>0</u>	<u>23</u>
<u>COARSE SAND</u> <u>↓ GRAVEL</u>	<u>23</u>	<u>103</u>

WELL LOCATION:  
sec. 6 T 27 N R 2 E  
8 miles EAST of Clarksdale  
(distance) (direction) (nearest town)

WELL PURPOSE: IRRIGATION  
(home, irrigation, municipal, industrial)

CODED

- WELL COMPLETION DATA:
- (1) diameter (inches) 12
  - (2) total depth (feet) 103
  - (3) static water level (feet) 16' below above top of ground.
  - (4) casing Steel, 63,  
(material) (depth)  
         if telescope see back.  
(size)
  - (5) screen 40, 63  
(length) (depth to top)  
12, Steel  
(size) (material)
  - (6) pump 60 1200  
(HP) (yield gpm)  
Diesel  
(type power)
  - (7) electric log           
(yes or no)  
          
(organization running log)
  - (8) how well bottom plugged Steel  
PLATE

RECEIVED


JUN 26 1987

Department of Natural Resources  
Bureau of Land & Water Resources

DRILLERS REMARKS:

If well telescopes please sketch and show depths.

GROUND LEVEL

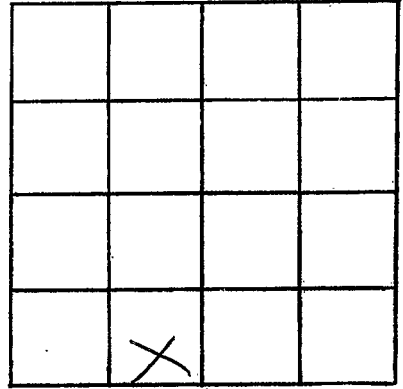

SECTION 6

Please indicate well location X.

ADDITIONAL INFORMATION

If more than one screen,  
show locations of each on sketch.