

MISSISSIPPI DEPARTMENT OF NATURAL RESOURCES

Bureau of Land and Water Resources

Southport Mall

P.O. Box 10631

Jackson, Mississippi 39209

WATER WELL DRILLERS LOG

CODED

Quitman
G-125

19 Powell Irrigation Inc Quitman

date well completed

firm name

county well located

LANDOWNER:	description of formations encountered	from	to
Meredith Bros	Clay	0	23
Clarksdale MS 38614 (mailing address)	COARSE SAND & GRAVEL	23	103

WELL LOCATION:
sec. 6-27 N R 2 E
8 S W
8 miles EAST of Clarksdale
(distance) (direction) (nearest town)

CODED

WELL PURPOSE: IRRIGATION
(home, irrigation, municipal, industrial)

- WELL COMPLETION DATA:
- (1) diameter (inches) 12
 - (2) total depth (feet) 103
 - (3) static water level (feet) 16' below above top of ground.
 - (4) casing Steel, 63,
(material) (depth)
 if telescope see back.
(size)
 - (5) screen 40, 63
(length) (depth to top)
12, Steel
(size) (material)
 - (6) pump 60, 1200
(HP) (yield gpm)
Diesel
(type power)
 - (7) electric log
(yes or no)

(organization running log)
 - (8) how well bottom plugged Steel
PLATE

RECEIVED


JUN 26 1987

Department of Natural Resources
Bureau of Land & Water Resources

DRILLERS REMARKS:

If well telescopes please sketch and show depths.

GROUND LEVEL

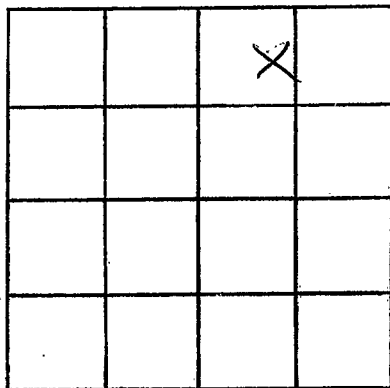

SECTION 6

Please indicate well location X.

ADDITIONAL INFORMATION

If more than one screen, show locations of each on sketch.