

State Well Report

Part 1

Mississippi Department of Environmental Quality
Office of Land and Water Resources
P.O. Box 10631
Jackson, MS 39289-0631
(601)961-5210
(601)354-6938 (fax)

For Office Use Only:

Aquifer: _____
Well #: G-132
L. S. Elevation: _____
E-log #: _____

County: Quitman
Permit #: _____
Driller: Willie L. Bryant
Date drilling completed: 4-16-06

State Law requires that this report be prepared by the driller in detail and filed with the Department within 30 days of completion of drilling of the well.

Well Owner Information	Well Location
Owner Name: <u>John B. Laney Jr.</u>	Latitude: <u>34° 14' 82"</u> Longitude: <u>090° 25' 55"</u>
Mailing Address: <u>North Delta Farms</u> <u>150 Laney Rd.</u> <u>Lyon MS 38645</u>	Method of Lat/Long (circle one): Conventional Survey, USGS quad <u>(Hand-held GPS)</u> , Survey-grade GPS
City: <u>Lyon</u> State: <u>MS</u> Zip Code: <u>38645</u>	<u>1/4</u> <u>1/4</u> Sec. <u>5</u> Twn <u>27N</u> Rng <u>2W</u>
Telephone No. <u>(602) 627-2040 - 624-4429</u>	Distance: <u>3.5</u> Miles Direction: <u>East</u> of Nearest Town: <u>Lyon</u>

Well Data

Purpose of Well (circle one) Home Industrial Public Supply Irrigation Fish Culture Other: Filling Tanks

Date well drilling started: 4-16-06 Date well drilling completed: 4-16-06

If flowing, method of flow regulation: Valve _____ Other (describe) _____

Static Water Level: 18 feet above or (below) (circle one) land surface Date measured: 4-16-06

Method of Measurement (circle one) steel tape electric tape air line other: Rope + weight

Hole depth: 110' Well depth: 110' Well grouted to a depth of 12 feet

Type of grout (circle one): Cement (Bentonite) Mix

Casing length: 90 feet Casing diameter: 4 inches Type of casing: PVC 160

Screen length: 20 feet Screen diameter: 4 inches Type of screen: SC# 40

Screen slot size: 0.13 inches Setting depth: From 90 feet to 110 feet

Type of completion (circle all applicable): (Gravel packed) Underreamed Telescoped Open hole Natural Development

Other (describe): _____

Top of lap pipe or reduction in casing: 0 feet. If telescoped or more than one screen, describe on back of page

Logs run (circle all applicable): (No log run) Electric Gamma Ray Density Sonic Neutron Other: _____

Name of organization running log(s): _____

I certify that the well was drilled, constructed, and completed in accordance with all applicable requirements of the Mississippi Department of Environmental Quality and/or the Mississippi Department of Health regulations and state laws.

Willie L. Bryant 0-639
Print Name of Water Well Contractor and License No.


Willie L. Bryant
Signature of Water Well Contractor

RECEIVED
MAY 18 2006
BY: OLWR

If well telescopes please sketch below and show depths.

G-132

Ground Level

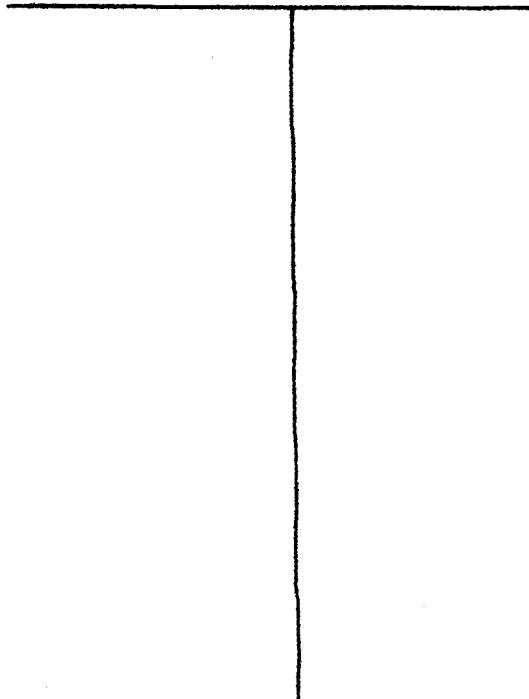

Description of Formations Encountered	From	To
Top Soil & Clay	0	20
Clay & Fine Sand	20	40
Fine & Med. Sand	40	60
Coarse Sand	60	80
Coarse sand & gravel	80	100
gravel	100	110

If more than one screen, show location of each on sketch

Sketch the property layout and include the following: 1) the well location; 2) any permanent structures on the property that may aid in locating the well; 3) any roads, power lines, or other items that may aid in locating the property and the well; 4) indicate direction.

Landowner Name: John B. Laney Jr.

Wilho L. Bryant
Signature of Water Well Contractor

RECEIVED
MAY 18 2006
BY: OLWR

STATE WELL REPORT

Part 2

Pump Installer's Completion Report
 Mississippi Department of Environmental Quality
 Office of Land and Water Resources
 P.O. Box 10631
 Jackson, MS 39289-0631
 (601)961-5210
 (601)354-6938 (fax)

County: Quitman
 Permit #: _____
 Driller: Willie L. Bryant
 Date completed: 5-13-06

For Office Use Only:

Aquifer: _____
 Well #: G-132
 Elevation: _____

This report should be prepared by the pump installer in detail and filed with the Department within 30 days of the installation of pump.

Well Owner Information	Well Location
Owner Name: <u>John B. Laney Jr.</u>	Latitude: <u>34° 14.82' N</u> Longitude: <u>89° 25.55' W</u>
Mailing Address: <u>North Delta Farms</u> <u>150 Laney Rd.</u>	Method of Lat/Long (circle one): Conventional Survey, USGS quad, <u>Hand-held GPS</u> , Survey-grade GPS
<u>Lyon</u> <u>MS</u> <u>38645</u>	_____ 1/4 _____ 1/4 Sec <u>5</u> Twn <u>27N</u> Rng <u>2W</u>
City State Zip Code	Distance Direction Nearest Town
Telephone No. <u>(662) 627-2040 - 624-4429</u>	<u>3 1/2</u> Miles <u>East</u> of <u>Lyon</u>

Pump Type Circle one	Power Type Circle one
Air Lift Jet <input type="radio"/> <u>Submersible</u> <input type="radio"/>	Diesel Engine Gasoline Engine Natural Gas
Bucket Piston <input type="radio"/> Turbine <input type="radio"/>	<u>Electric Motor</u> <input type="radio"/> Hand <input type="radio"/> Tractor PTO <input type="radio"/>
Centrifugal Rotary <input type="radio"/> Flowing Well <input type="radio"/>	Windmill Other (specify): _____
Other (specify): _____	Horse Power Rating of Motor: <u>2 HP</u>
Date Pump Installed: <u>4-16-06</u>	Setting Depth: <u>60</u> feet
Rated Pump Capacity: <u>80</u> Gallons Per Minute	Number of Stages: <u>6</u>

Pump Test Data	Method of Measuring Water Level Circle one
Date Well Tested: <u>5-13-06</u>	Air Line Electric Measuring Line Steel Tape
Static Water Level (A): <u>18'</u> Feet Below Land Surface	Other (specify): <u>Rope & weight</u>
Pumping Water Level (B): <u>23'</u> Feet Below Land Surface	For flowing well, measured shut in head: _____ feet
Drawdown [(B) - (A)]: <u>5'</u> Feet Below Land Surface	Well yielded <u>80</u> GPM with a drawdown of
Test Pumping Rate: <u>80</u> Gallons Per Minute	<u>5</u> feet after <u>4</u> hours of pumping
Duration of Pump Test (minimum 4 hours): <u>4</u> hours	

I HEREBY CERTIFY that the above statements are true to the best of my knowledge.

Willie L. Bryant 0-639 Willie L. Bryant
 Print Name of Pump Installer and License No. (if applicable) Signature of Pump Installer

RECEIVED
 MAY 18 2006
 BY: OLWR