
| County: Quitman Permit #: Permit #: Driller: Willing completed: 7-2-07 State Well Report Part 1 Mississippi Department of Environmental Quality Office of Land and Water Resources Aquifer: P.O. Box 10631 Well #: Jackson, MS 39289-0631 L. S. Elevation: (601)961-5210 E-log #: | | | | | | | |
|---|----------|--|--|--|--|--|--|
| State Law requires that this report be prepared by the driller in detail and filed with the Department within 30 days of completion of drilling of the well. | | | | | | | |
| Well Owner Information Well Location Owner Name Shady Grove M.B. Church Latitude: 34° 11,76" Longitude: 690° 26 °01 | <u>~</u> | | | | | | |
| Mailing Address: <u>Tony</u> <u>Barnes</u> Method of Lat/Long (circle one): Conventional Survey, <u>1028 Barnes</u> USGS quad Hand-held GPS, Survey-grade GPS | | | | | | | |
| Clarksdale MS 38614 City State Zip Code Distance Direction Nearest Town | | | | | | | |
| Telephone No. (662) 627-1682 Distance Direction Nearest Town Well Data | | | | | | | |
| Purpose of Well (circle one) Home Industrial Public Supply Irrigation Fish Culture Other: | | | | | | | |
| Date well drilling started: $7 - 2 - 07$ Date well drilling completed: $7 - 2 - 07$ | | | | | | | |
| If flowing, method of flow regulation: Valve Other (describe) Static Water Level: feet above or below circle one) land surface Date measured: 7-2-0.7 | | | | | | | |
| Method of Measurement (girgle one) steel tone electric tone oir line other: PARE & WE BEFT ~. | | | | | | | |
| Hole depth: <u>100</u> Well depth: <u>100</u> Well grouted to a depth of <u>10</u> AGG () 3 2007 Type of grout (circle one): Cement Bentonite Mix | | | | | | | |
| Casing length: <u>90</u> feet Casing diameter: <u>4</u> inches Type of casing: <u>PYC SCH492</u> WR | | | | | | | |
| Screen length: <u>10</u> feet Screen diameter: <u>4</u> inches Type of screen: <u>PVC S10 Hed</u> | | | | | | | |
| Screen slot size: inches Setting depth: From feet to feet | | | | | | | |
| Type of completion (circle all applicable): Gravel packed Underreamed Telescoped Open hole Natural Development Other (describe): | | | | | | | |
| Top of lap pipe or reduction in casing:feet. If telescoped or more than one screen, describe on back of page | | | | | | | |
| Logs run (circle all applicable): No log run Electric Gamma Ray Density Sonic Neutron Other: | | | | | | | |
| Name of organization running log(s): | | | | | | | |
| Department of Environmental Quality and/or the Mississippi Department of Health regulations and state laws. Willie L. Bryant 0-0639 Willie L. Bryant | | | | | | | |

Print Name of Water Well Contractor and License No.

Signature of Water Well Contractor


If well telescopes please sketch below and show depths.

Ground Level

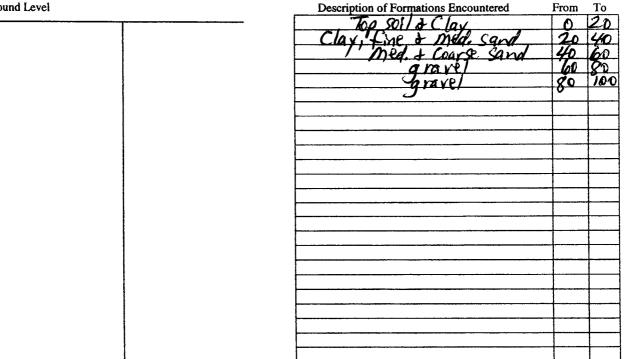

6-136

If more than one screen, show location of each on sketch

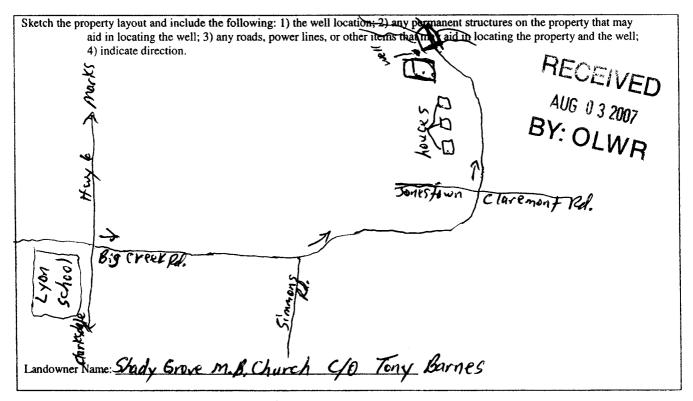

Wallo K. Buyan Signature of Water Well Contractor

| • | STATE W | ELL REPORT | |
|--|--|---|---------------------------------------|
| County: Quitman Permit #: Driller: Willie Bryant Date completed: 7-2-07 | Pump Installer Mississippi Departme Office of Land P.O. Jackson, J (601 | and Water Resources Box 10631 MS 39289-0631 V61-5210 | For Office Use Only: uifer: |
| This report should be prepared by th installation of pump. | e pump installer in deta | il and filed with the Department wi | thin 30 days of the |
| Well Owner Informat | tion | Well Loc | ation |
| Owner Name: Shady Grove M. | | Latitude: <u>34° 11. 76 N</u> Lor | ngitude: 090° 26.01 V |
| Mailing Address: Tony Barn | | Method of Lat/Long (circle one): (| Conventional Survey, |
| 1028 Barn | ies | USGS quad, Hand-held | GPS, Survey-grade GPS |
| Clar Ks dale, ms 38614 City State Zip Code | | 1414 Sec19 | Twn 27N Rng 2W |
| City State Zip Codé | | Distance Direction | Nearest Town |
| Telephone No. (662, 627-168 | 2 | 35 Miles SE of | yon School |
| Pump Type Circle one | | Power 7 Circle | |
| Air Lift Jet | Submersible | Diesel Engine Gasoline En | gine Natural Gas |
| Bucket Piston | Turbine | Electric Motor Hand | Tractor PTO |
| Centrifugal Rotary | Flowing Well | Windmill Other (spec | · 17m |
| Other (specify): | | Horse Power Rating of Motor: | 1/ RECEIVE |
| Date Pump Installed: <u>7-2-0</u> | 7 | Setting Depth:60 ' | AUGery 2 22 |
| Rated Pump Capacity: | _Gallons Per Minute | Number of Stages: | BY: OLWA |
| Pump Test Data | | Method of Measur | · · · · · · · · · · · · · · · · · · · |
| ~ ~ ~ ~ | | Circle | one |
| Date Well Tested: /- / -0/ | | | |
| Date Well Tested: $7-3-07$ Static Water Level (A): 28 Fee | | | g Line Steel Tape |
| Static Water Level (A):Fee | t Below Land Surface | Air Line Electric Measurin Other (specify): Rope & we | |
| | t Below Land Surface Below Land Surface | | light |
| Static Water Level (A): <u>28</u> Fee Pumping Water Level (B): <u>29</u> Feet | t Below Land Surface Below Land Surface t Below Land Surface | Other (specify): Rope + we | head:feet |

| WITTE | LID | ïV | an | T | 0~005/ |
|------------|---------|-----|--------|-----|-----------------------------|
| Print Name | of Pump | Ins | taller | and | License No. (if applicable) |

Walky K. Buyant Signature of Pump Installer ---