
State W	ell Report	C. Office Hee Online			
	Oriller's Log	For Office Use Only:			
Mississippi Departmen	nt of Environmental Quality and Water Resources	Aquifer:			
PO	Box 2309	Well #:			
1 - 1 - 1	n, MS 39225 961- 5210	L. S. Elevation:			
Data drilling completed: "\"\"	1- 5228 (fax)	E-log #:			
	Land to be alder man augible for the				
State Law requires that this report be prepared by the lic Department at the above address within 30 days of com	ense notuer responsible for in pletion of drilling of the well (or borehole.			
Information on Well Owner	Well or Bor	ehole Location			
(Landowner if borehole is not for a water well) Owner Name Buckskin Pantation	Latitude: 3H ° 10 '21'	, Longitude: <u>90°21 ', 34"</u>			
Mailing Address: 708 Walnut Street	Method of Lat/Long (circle one	e): Conventional Survey,			
Maning readous.	USGS quad, Hand-held	GPS Survey-grade GPS			
Marks Mc 381040		Twn 27N Rng ODW			
City State Zip Code	NEDistance Direction Miles West of	Nearest Town f lamber			
Telephone No. ()_					
Well / Bore	hole Data				
Date drilling started: 3-4-13 Date drilling completed: 3-4-13 Hole depth: 120 Hole diameter: 21in					
Location of the source of any surface water used for drilling: Weaves + Well Method of dosing and volume of Chlorine used in drilling and development:					
Logs run (circle all applicable): No log run Electric Gamma Ray Density Sonic Neutron Other: Name of organization running log(s):					
Purpose of borehole (check one): Water WellGeotechnical/Geol	ogical Investigation Ground	Source Heat Pump			
Seismic Survey Other (describe) Replaces GNO 7009					
If drilling is not related to water well construction, skip the remainder of this block					
Purpose of Well (check one): Home Industrial Public Supply	Irrigation Fish Culture	Other:			
If a flowing well, method of flow regulation: Valve Other (describe)					
Static Water Level: 18 feet above or below (circle one) land surface Date measured: 3-4-13					
Method of Measurement (circle one) steel tape electric tape air line other:					
Well depth: 120 Well grouted to a depth of 15 feet Type of grout (circle one): Neat Cement Bentonite Mix					
Casing length: 60 feet Casing diameter: 1	inches Type of casing:	pvc			
Screen length: 40 feet Screen diameter: 12 inches Type of screen: 100					
Screen slot size: .50 inches Setting depth: From £80 icet to 70 120 icet					
Type of completion (circle all applicable). Gravel packed Underreamed Telescoped Open hole Natural Development					
Other (describe):					
Top of lan nine or reduction in easing:	seconad or more than one screen	e describe on next nage			

Form: OLWR-PRECEWED



The sketch below only required for water wells

If well telescopes, show depths on sketch.

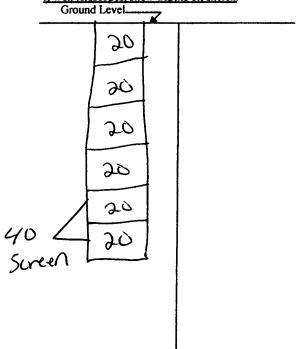

Description of formations encountered must be provided for all wells and boreholes, unless specifically exempted by regulations

Description of Formations Encountered	From (depth)	To (depth)
Gunba	Ground Level	20
Sand	90	40
Sanc	40	(00)
Course sand	(0)	80
sand + armel	80	00
Sand + gravel	100	120
<u> </u>		
		<u> </u>
		<u> </u>
•		
	<u> </u>	
		<u> </u>
]

If more than one screen, show location of each on sketch

Sketch the property layout and include the following: 1) the well location; 2) any permanent straid in locating the well; 3) any roads; power lines, or other items that may aid in locating the well; 3) any roads; power lines, or other items that may aid in locating the well; 3) any roads; power lines, or other items that may aid in locating the well; 3) any roads; power lines, or other items that may aid in locating the well; 3) any roads; power lines, or other items that may aid in locating the well; 3) any roads; power lines, or other items that may aid in locating the well; 3) any roads; power lines, or other items that may aid in locating the well location; and the well location is a location to the well location in locating the well location is a locating the well location in locating the well location is a locating the well location in locating the well location is a locating the well location in locating the well location is a locating the well location in locating the well location is a locating the well location in locating the well location is a locating the well location in locating the well location is a location in locating the well location in locating the well location is a locating the well location in locating the well location is a location in locating the well location in location in location in locating the well location in location	uctures on the property that may ocating the property and the well;
4) a north arrow. Well	Land
Buckshing	
Clarhidale	
352	
Landowner Name: Buckskin Plantation	Form: OLWR-SWR-1A (04/08)

I certify that the well/borehole was drilled, constructed, and completed in accordance with all applicable requirements of the Mississippi Department of Environmental Quality and the Mississippi Department of Health regulations, if applicable, and state laws.

| Signature of Licensee | MAR 2 5 2013 | Signature of Licensee | MAR 2 5 2013 | Signature of Licensee | Signature | Signature of Licensee | Signatu

D. OLWR

	STATE WI	ELL REPORT	,		
County: Quitman		art 2		For Office Use Only:	
Permit #: <u>Gw - 46851</u>		s Completion Report	Aq	juifer: 6 148	
Driller: JOEL Junks	Mississippi Department of Environmental Quality Office of Land and Water Resources		·	ell #:	
Date completed: 3-4-13		Box 2309 ı, MS 39225		Elevation:	
Copy information from block on Part 1	• ,	961-5210 1-5228 (fax)	Lie Lie	vacion.	
This part of the report must be completed by a report must be attached and both parts filed wi	licensed water well o th the Department a	contractor or a licensed	l pump installe	er. A copy of Part 1 of the	
Well Owner Information	on the Department to	ine noove muress with	Well Loca		
Owner Name: RIVEROALE FARM	<u> </u>	Latitude: 34 0/0/	Z/" Long	gitude: 90 ° 21 · 34 v	
Mailing Address: 143 Byzo C	bue			Conventional Survey,	
		USGS quad, Ha	ınd-held GPS_	, Survey-grade GPS	
Claresage ms City State	386N	_		T 27N R 2W	
	•	NE			
Telephone No. (662) 627 - 7792		Distance Dire	\mathcal{L} of \mathcal{L}	Nearest Town	
Pump Type			Power T	ype	
Circle one Air Lift Jet Sub	mersible	Diesel Engine	Circle of Gasoline Eng	one	
Bucket Piston Turb	oine)	Electric Motor	Hand		
	ving Well			Tractor PTO	
•	And McII			y):	
Other (specify):				60	
Date Pump Installed: 3-14-13		Setting Depth:			
Rated Pump Capacity: //OO Gallo	ns Per Minute	Number of Stages:			
Pump Test Data		Method	of Measurin	g Water Level	
Date Well Tested:		Air Line Electr	Circle or	Line Steel Tape	
Static Water Level (A):Feet Below	Land Surface				
Pumping Water Level (B):Fect Below	Land Surface	Other (specify):			
Drawdown [(B) – (A)]:Feet Below	Land Surface	For flowing well, meas	ured shut in he	ead:feet	
Test Pumping Rate:Gallon		Well yielded	GPM	with a drawdown of	
Duration of Pump Test (minimum 4 hours):	ŀ	feet a	after	hours of pulmoing	
				HECEN	
This is for (simple one): Now Well B				with a drawdown of hours of purifice MAR 2 9 207	
This is for (circle one): New Well R	eplacement of Existi	ng Pump Repai	ir of Existing I	Yump 4920;	
				RV	

I HEREBY CERTIFY that the above statements are true to the best of my knowledge.

Print Name of Pump Installer and License No. (if applicable)

Form: OLWR-SWR-1C (07-09)

Signature of Pump Installer

12 1150