
Etaio V	/all Danart	
	/ell Report Driller's Log	For Office Use Only:
	nt of Environmental Quality	Aquifer:
Permit # 4892 Office of Land a	nd Water Resources	Well # G159
	Box 2309 n, MS 39225	
(601)	961- 5210	L. S. Elevation:
Date drilling completed: 7-11-15 (601)96	1- 5228 (fax)	E-log #:
State Law requires that this report be prepared by the lice	ense holder responsible for	the work and filed with the
Department at the above address within 30 days of com	pletion of drilling of the well	or porenoie.
Information on Well Owner (Landowner if borehole is not for a water well)		prehole Location
Q bello France	Latitude: 39 0 2 , 44	" Longitude: 90 ° 22 '310"
	Method of Lat/Long (circle or	ne): Conventional Survey,
Mailing Address: Slole Liney Kielge	USGS quad, Hand-held	d GPS) Survey-grade GPS
Koocl	MEN Staly Ser 14	Twn 27N Rng OZW
Clarksdak Ms 38619		
City State Zip Code	Distance Direction Miles SE	of Barksdale
Telephone No. ()		
Well / Bord	hale Data	
		2/10
-11	Hole depth:	Hole diameter:
Date drilling started: 7-11-15 Date drilling completed: 7-11-		
Location of the source of any surface water used for drilling:	leavest Well	
Location of the source of any surface water used for drilling:	lopment:	
Location of the source of any surface water used for drilling:	Density Sonic Neutron	Other:
Location of the source of any surface water used for drilling:	Density Sonic Neutron Ogical Investigation Ground	Other:
Location of the source of any surface water used for drilling:	Density Sonic Neutron Ogical Investigation Ground	Other:
Location of the source of any surface water used for drilling:	Density Sonic Neutron Ogical Investigation Ground Density the remainder of this bl	Other:
If drilling is not related to water well construction Purpose of Well (check one): Home Industrial Public Supply	Density Sonic Neutron Ogical Investigation Ground Density the remainder of this bl	Other:
Location of the source of any surface water used for drilling:	Density Sonic Neutron Ogical Investigation Ground Ogical Investigation Ground Ogical Investigation Ground Ogical Investigation Fish Culture Ogical Investigation Fish Culture Ogical Investigation Fish Culture Ogical Investigation Fish Culture	Other:
Location of the source of any surface water used for drilling:	Density Sonic Neutron Ogical Investigation Ground Ogical Investigation Ground Ogical Investigation Ground Ogical Investigation Fish Culture Ogical Investigation Fish Culture Ogical Investigation Fish Culture Ogical Investigation Fish Culture	Other:
Location of the source of any surface water used for drilling:	Image: Construction of the second	Other:
Location of the source of any surface water used for drilling:	Image: Construction of the second	Other: d Source Heat Pump <u>ock</u> Other: T-12-15 went Bentonite Mix
Location of the source of any surface water used for drilling:	Image: Construction of the second	Other: I Source Heat Pump ock Other: T-12-15 ment Bentonite Mix puc
Location of the source of any surface water used for drilling:	Image: Construction of the second	Other: I Source Heat Pump ock Other: T-12-15 ment Bentonite Mix puc
Location of the source of any surface water used for drilling:	Image: Construction of the second sector of the	Other: I Source Heat Pump ock Other: 7-12-15 Hent Bentonite Mix puc fuct fu
Location of the source of any surface water used for drilling:	lopment:	Other: I Source Heat Pump ock Other: T-12-15 went Bentonite Mix PUC NUC To LIS feet hole Natural Development
Location of the source of any surface water used for drilling:	lopment:	Other: I Source Heat Pump ock Other: Other: 7-12-15 Mix PUC Mix feet hole Natural Development

AUG 3 1 2015 BY: OLWR




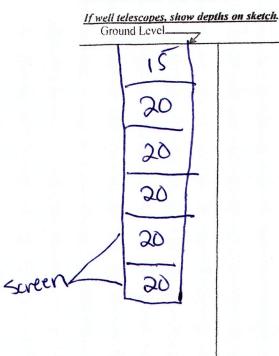

Description of formations encountered must be provided for all wells and boreholes, unless specifically exempted by regulations

Description of Formations Encountered		To (depth)
Gumbo	Ground Level	20
sand	30	40
Course sandy	40	60
Course sanch	60	50
areuel + sand.	80	100
araul + sand	100	115
	<u> </u>	

If more than one screen, show location of each on sketch

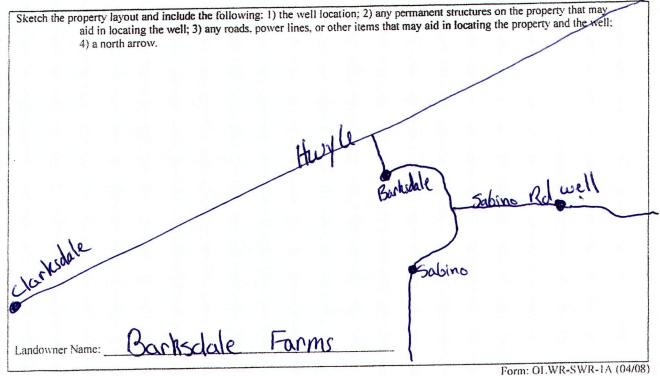

nn

I certify that the well/borehole was drilled, constructed, and completed in accordance with all applicable requirements of the Mississippi Department of Environmental Quality and the Mississippi Department of Health regulations, if applicable, and state

laws. Jumper Joel Date

Signature of Licensee

Print Name of Responsible Licensee and License No.

BY: OLWR

AUG 31 2015

STATE WELL REPORT	
County: QUITMAN Part 2 For Office Use	Only
Bump Installer's Completion Deport	
Permit #: <u>JOEL JUMAR</u> Driller: <u>JOEL JUMAR</u> Mississippi Department of Environmental Quality Office of Land and Water Resources	
Date completed: 7-11-15 P.O. Box 2309	
Lackson, MS 39225-2309 Aquifer: Copy information from block on Part 1 (601)961-5210	
(601) 360-0535 (fax)	_
This part of the report must be completed by a licensed water well contractor or a licensed pump installer. A copy of of the report must be attached and both parts filed with the Department at the above address within 30 days of well c	Part 1 ompletion.
Well Owner Information Well Location	
Owner Name: BARKSDALE FARMS Latitude: 34.12.43. Longitude: 90.22.	41 .
Mailing Address: <u>See UENEY PIOLA PD</u> Method of Lat/Long (check one): Conventional Surve	
USGS quad, Hand-held GPS, Survey-grade	
CLARFSDALS MS 38614 NE 1/4 SW 1/4, Sec 1/4 T 27N R City State Zip Code 1/1/1 SW 1/4, Sec 1/4 T 27N R	
1/2 and 1/2 Miles SE of BARASDALE	
Telephone No. (162) 902-6709 (Distance) (Direction) (Nearest Town	7)
Pump Type (circle one)	
Submersible (Turbine) Air Lift Centrifugal Flowing Well Jet Piston Rotary Other (describe):	
Date Pump Installed:	Per Minute
Is This Pump (circle one): New Repaired Replacement USED	
Power Type (circle one)	
Electric Biesel Gasoline Natural Gas Tractor PTO Windmill Other (<i>describe</i>):	
Horse Power Rating of Motor: 00 Setting Depth: 50 feet Number of Stages: 2	
Pump Test Data for Non Flowing Well	
Date Well Tested: Duration of Pump Test (minimum 4 hours):	hours
Static Water Level (A): Feet Below Land Surface Pumping Water Level (B): Feet Below Lar	nd Surface
Drawdown [(B) - (A)]:Feet Below Land Surface Test Pumping Rate: Gallons P	
Method of measurement (circle one): Steel tape Electric tape Air line Other (describe):	
Pump Test Data for Flowing Well	
Measured shut in head:feet.	
Well yielded GPM with a drawdown of feet afterhours of pumping	
Meter Installation	
Meter Manufacturer: Meter Serial Number:	
Meter Model Number/Name: Type of Meter:	
Totalizer Register Unit and Multiplier Factor (AF x .001, gal x 1000, etc):	
Installation Date: Meter installed by:	
Installation Date: Meter installed by: Is This Meter (circle one): New Repaired Replacement Important: By submitting the above information you are certifying that this meter was installed to manufacturer sta For agricultural wells, a list of approved meters is on the MDEQ website	indards.
Is This Meter (circle one): New Repaired Replacement Important: By submitting the above information you are certifying that this meter was installed to manufacturer sta For agricultural wells, a list of approved meters is on the MDEQ website	indards.
Is This Meter (circle one): New Repaired Replacement Important: By submitting the above information you are certifying that this mater was installed to manufactures are	indards.