

QUITMAN  
H25  
7-16-63

WATER WELL DRILLERS LOG

CODED

H25

Date: 7-16-, 1963, Driller: Layne-Central Co. County Quitman

(Name)

- (1) Owner of Land: Town of Lambert  
(Name)  
Lambert, Mississippi  
(Address)
- (2) Location: 1/4, 1/4, Sec. 22 T27N R1W  
\_\_\_\_\_ miles \_\_\_\_\_ of \_\_\_\_\_  
(distance) (direction) (Nearest Town)
- (3) Topography: \_\_\_\_\_  
(Hilly) (Flat) (Level)
- (4) Purpose of Well: municipal  
(Domestic Irrigation  
Municipal, Industrial, Other)

Description & Color of Materials Sand, Clay, Red Clay, Shell, etc.	Thick- ness feet	Depth feet
0-7	Clay	
7-38	Sand	
38-161	Sand & gravel	
161-180	clay	
180-209	sandy clay	
209-357	sand	
357-361	clay	
361-381	sand	
381-410	sand & clay	st.
410-433	sandy clay	
433-478	shale	
478-500	sandy shale	
500-719	hard shale	
719-735	sand	
735-750	sandy shale	
750-788	hard shale	
788-830	fine sand	
830-839	sandy shale	
839-882	sand & shale	st.
882-910	soapstone	
910-944	sandy shale	
944-1000	hard shale	


Information upon completion of well:

- (1) Diameter 10 inches.
- (2) Total Depth 887 feet.
- (3) Water Level 6 plus \_\_\_\_\_ flowed \_\_\_\_\_ feet below top of ground.
- (4) Cased to 825, Size 10"
- (5) Screen: Size 6", Length 50'
- (6) Were any formations sealed against pollution?  
x yes, \_\_\_\_\_ no.

If YES depth of formation 825'  
Why \_\_\_\_\_ required

Drillers Remarks: \_\_\_\_\_  
\_\_\_\_\_  
\_\_\_\_\_

CODED

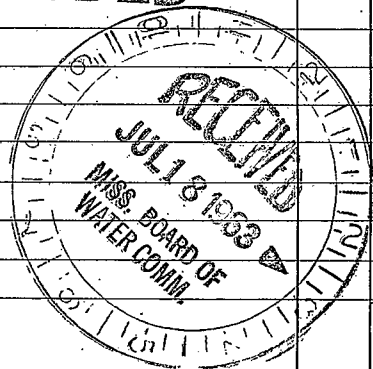

(Use Back Side)

Well No.

