

QUITMAN MI.

H 26

12-19-65

WATER WELL DRILLERS LOG

CODED

Date: DEC 19, 1965, Driller: DELTA DRILLING Co. County: SPITZ MINN.

E Log # 5

(Name)

(1) Owner of Land: ROY FLOWERS #
J.L. EASLEY RESD., CROWDER, MISS.
MATTSON, MISS.

(2) Location: E/2 SE 1/4, NE 1/4, Sec. 25 27N 14W
_____ miles _____ of _____
(distance) (direction) (Nearest Town)

(3) Topography: _____
(Hilly) (Flat) (Level)

(4) Purpose of Well: DOMESTIC
(Domestic Irrigation, Municipal, Industrial, Other)

Information upon completion of well:

(1) Diameter 3 inches.

(2) Total Depth 584 feet.

(3) Water Level FLOWS feet below top of ground.

(4) Cased to 564, Size 3" - 350' / 2" - 235'

(5) Screen: Size 2", Length 20'

(6) Were any formations sealed against pollution?
_____ yes, _____ no.


If YES depth of formation _____

Why _____

Drillers Remarks: 21' LAP OF 2" IN
3" PIPE
FLOWS - 35 gpm -

Description & Color of Materials Sand, Clay, Red Clay, Shell, etc.	Thick- ness Feet	Depth Feet
gumbo	21	21
Sand	64	85
gravel	41	126
Sand	14	140
gumbo w/rock	50	190
Shale	32	222
green sand	38	250
Shale	31	281
Sand	27	308
gumbo	68	376
Shale	32	408
Sand	30	438
gumbo	36	474
Shale	32	506
Sand	66	572
gumbo	12	584

CODED

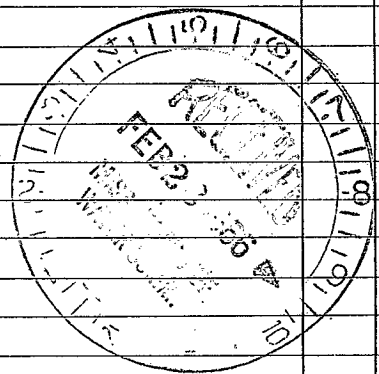

Well No.

(Use Back Side)

