

QUITMAN

MISSISSIPPI BOARD OF WATER COMMISSIONERS

H 27

1-3-66

WATER WELL DRILLERS LOG

CODED

Date: JAN 3, 1966, Drillers: DELTA DRILLING Co County QUITMAN

E Log # 6

(Name)

(1) Owner of Land: ROBERT COE

(Name)

LAMBERT, MISS.

(Address)

(2) Location: NW 1/4 SE 1/4, SE 1/4, Sec. 32 T27R1W

\_\_\_\_\_ miles \_\_\_\_\_ of \_\_\_\_\_

(distance)

(direction)

(Nearest Town)

(3) Topography:

(Hilly)

(Flat)

(Level)

(4) Purpose of Well: DOMESTIC

(Domestic Irrigation  
Municipal, Industrial, Other)

Information upon completion of well:

(1) Diameter 4 inches.

(2) Total Depth 926 feet.

(3) Water Level FLOWS feet below top of ground.

(4) Cased to 908' Size 2" - 424'

(5) Screen: Size 2" Length 20'

(6) Were any formations sealed against pollution?

\_\_\_\_\_ yes, \_\_\_\_\_ no.


If YES depth of formation \_\_\_\_\_

Why \_\_\_\_\_

Drillers Remarks: 24' LAP OF 2" IN 3"

Pipe - FLOWS 15 gpm -

Description & Color of Materials Sand, Clay, Red Clay, Shell, etc.	Thick- ness Feet	Depth Feet
Gumbo	20	20
Sand	43	63
gravel	71	134
Gumbo	43	177
Sand	43	220
Gumbo	65	285
Sand	31	316
Shale	41	357
Sand	41	398
Shale	28	426
green sand w/rocks	40	466
Shale	40	506
sand w/rocks -	18	524
green shale	10	534
Brown sand	20	554
Shale	22	576
Gumbo	88	664
Shale	52	716
Gumbo	16	732
Shale	26	758
Gumbo	6	764
Sand	22	786
Shale	24	810
Sand	46	856
Shale	34	890
Sand	26	916
Gumbo	10	926

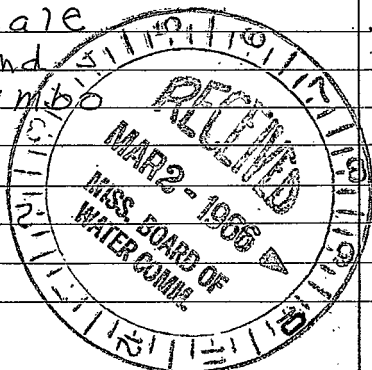

(Use Back Side)

Well No.

