

Gutman
H 29
8-15-69

MISSISSIPPI
BOARD OF WATER COMMISSIONERS
416 North State Street
Jackson, Mississippi 39201

CODED
CODED

WATER WELL DRILLERS LOG

August 15 1969 *Deer Creek Farms* *Deer Creek Farms* *Deer Creek Farms*
date well completed firm name county well located

LANDOWNER: *Deer Creek Farms*
Alan Wright
Rambert, Miss.

description of formations encountered	from	to
<i>Clay</i>		<i>14</i>
<i>Sand</i>	<i>14</i>	<i>40</i>
<i>Sand & Gravel</i>	<i>40</i>	<i>105</i>

(mailing address)

WELL LOCATION:
sec. *20* T. *27* N. R. *1* E. S. *32*
5 miles *east* of *Rambert*
(distance) (direction) (nearest town)

WELL PURPOSE: *Irrigation*
(home, irrigation, municipal, industrial)

WELL COMPLETION DATA:

- (1) diameter (inches) 6"
- (2) total depth (feet) 105'
- (3) static water level (feet) _____ below/above top of ground.
- (4) casing _____ (material) 21' (depth)
_____ (size) if telescope see back.
- (5) screen 40 (length) _____ (depth to top)
6 (size) _____ (material)
- (6) pump 3 (HP) _____ (yield gpm)
electric (type power)
- (7) electric log _____ (yes or no)
_____ (organization running log)
- (8) how well bottom plugged *Unplugged*

CODED


OCT 23 1969

DRILLERS REMARKS:

MISS. BD. OF
WATER COMM.

If well telescopes please
sketch and show depths.

GROUND LEVEL

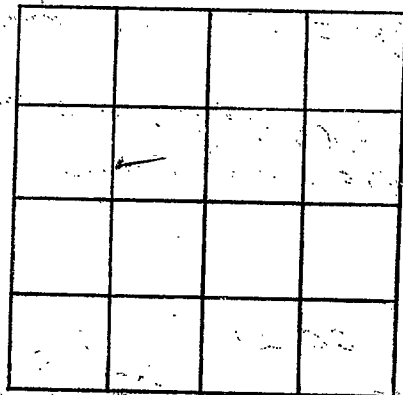

SECTION 20

Please indicate well location X.

ADDITIONAL INFORMATION

If more than one screen,
show locations of each on sketch.