

MISSISSIPPI
BOARD OF WATER COMMISSIONERS
416 North State Street
Jackson, Mississippi 39201

CODED

WATER WELL DRILLERS LOG

7-24-69
date well completed

19 *Five Cent Farm*
firm name

Quitman
county well located

LANDOWNER: *Jimmy Robinson*

description of formations encountered

from to

Mark, Miss.

(mailing address)

WELL LOCATION:

sec. 3 T 27 N R 10 E
S
2 miles South of Mark
(distance) (direction) (nearest town)

| | | |
|-------------|--|---------|
| Clay | | 23 |
| Sand | | 20-22 |
| Gravel Sand | | 23 107 |
| Gravels | | 107 150 |
| Clay | | 150 560 |
| Sand | | 560 667 |
| Gravel Sand | | 668 711 |
| Clay | | 716 |

WELL PURPOSE: *Home*
(home, irrigation, municipal, industrial)

WELL COMPLETION DATA:

- (1) diameter (inches) 2"
- (2) total depth (feet) 667'
- (3) static water level (feet) _____ below above top of ground.
- (4) casing Galv. 667'
(material) (depth)
_____ if telescope see back.
(size)
- (5) screen 20' 667'
(length) (depth to top)
2" Steel Pipe
(size) (material)
- (6) pump 3/4 20
(HP) (yield gpm)
Edco.
(type power)
- (7) electric log no.
(yes or no)

(organization running log)
- (8) how well bottom plugged Point

CODED


AUG 26 1969

MISS. BD. OF WATER COMMISSIONERS

DRILLERS REMARKS:

If well telescopes please sketch and show depths.

GROUND LEVEL

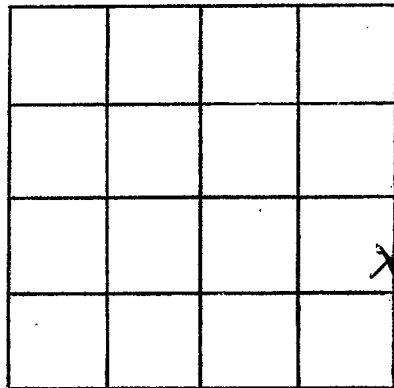

SECTION 3

Please indicate well location X.

ADDITIONAL INFORMATION

If more than one screen,
show locations of each on sketch.