

QUITMAN

H 32

9-30-70

MISSISSIPPI
 BOARD OF WATER COMMISSIONERS
 416 North State Street
 Jackson, Mississippi 39201

CODED
 10/23/70
 JW
 23309

WATER WELL DRILLERS LOG

September 30, 19 70 SINGER-Layne Central Division Quitman
 date well completed firm name county well located

LANDOWNER: Miss. State Game &
 Fish Commission
 O'Keefe Waterfowl

description of formations encountered

from

to

Clay

0

15

Coarse sand

15

25

Sand and big gravel

25

115

Jackson, Mississippi

(mailing address)

WELL LOCATION:

sec. 24 T 27 N R ~~XX~~ ~~XX~~ W
 XX

6 miles south of Lambert
 (distance) (direction) (nearest town)

WELL PURPOSE: irrigation
 (home, irrigation, municipal, industrial)

WELL COMPLETION DATA:

- (1) diameter (inches) 16
- (2) total depth (feet) 115
- (3) static water level (feet) 13' 9" below top of ground. ~~above~~
- (4) casing steel, 55' (material) (depth)
 16" (size) if telescope see back.
- (5) screen 60' (length), 115' (depth to top)
 16" (size), Armco (material)
- (6) pump 60 (HP), 3000 (yield gpm)
 electric (type power)
- (7) electric log no (yes or no)
 (organization running log)
- (8) how well bottom plugged plate

CODED


OCT 29 1970

MISS. Bd. OF WATER COM.

DRILLERS REMARKS:

If well telescopes please sketch and show depths.

GROUND LEVEL

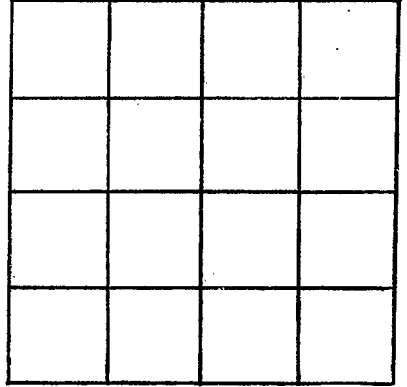

SECTION _____

Please indicate well location X.

ADDITIONAL INFORMATION

If more than one screen,
show locations of each on sketch.