

QUITMAN
H33
6-25-72

MISSISSIPPI
BOARD OF WATER COMMISSIONERS
416 North State Street
Jackson, Mississippi 39201
WATER WELL DRILLERS LOG

CODED

6-25 1972 Buena Vista Quitman
date well completed firm name county well located

LANDOWNER: SELF-CO.

MARK'S MISS
38646
(mailing address)

description of formations encountered

from to

Clall 0 15
fine sand 15 65
Coarse sand
Gravel 65 118

WELL LOCATION:

sec. 12 T 27 N R 1 E
1/2 miles S-E of MARK'S
(distance) (direction) (nearest town)

WELL PURPOSE: Irrigation
(home, irrigation, municipal, industrial)

WELL COMPLETION DATA:

- (1) diameter (inches) 20"
- (2) total depth (feet) 118'
- (3) static water level (feet) 15 below
above top of ground.
- (4) casing 3/4" x 12", 78'
(material) (depth)
if telescope see back.
(size)
- (5) screen 40'-0" (length), (depth to top)
12" (size), 3/16" Steel (material)
- (6) pump 100 (HP), 2000 (yield gpm)
unit (type power)
- (7) electric log no (yes or no)
(organization running log)
- (8) how well bottom plugged steel plate

CODED


JUN 16 1972

DRILLERS REMARKS:

MISS. BD. G.
CATER BOMB.

If well telescopes please sketch and show depths.

GROUND LEVEL

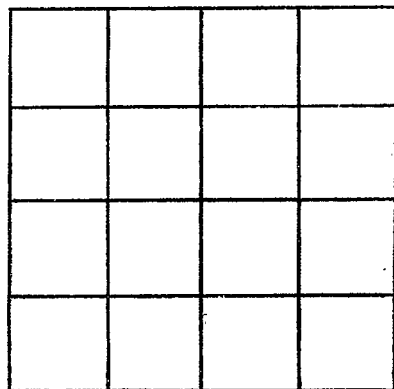

SECTION _____

Please indicate well location X.

ADDITIONAL INFORMATION

If more than one screen,
show locations of each on sketch.