

QUITMAN
H34
6-20-72

MISSISSIPPI
 BOARD OF WATER COMMISSIONERS
 416 North State Street
 Jackson, Mississippi 39201
Oran Harper
 WATER WELL DRILLERS LOG

CODED

6-20-72 date well completed 1923 BIRLA VISTA firm name QUITMAN county well located

LANDOWNER: SELF CO
MARKS MISS
38646
 (mailing address)

description of fomations encountered	from	to
<u>Clay</u>	<u>0</u>	<u>15</u>
<u>fine sand</u>	<u>15</u>	<u>70</u>
<u>course sand</u>	<u>70</u>	<u>118</u>
<u>Gravel</u>		

WELL LOCATION:
 sec. 1 T. 27 N. R. 1 E.
1/2 miles S-E of MARKS
 (distance) (direction) (nearest town)

WELL PURPOSE: irrigation
 (Irrigation, municipal, industrial)

- WELL COMPLETION DATA:
- (1) diameter (inches) 20"
 - (2) total depth (feet) 118'
 - (3) static water level (feet) 15 below above top of ground.
 - (4) casing 3/4" x 12', 78',
 (material) (depth)
 _____ if telescope see back.
 (size)
 - (5) screen 40', _____
 (length) (depth to top)
12, 3/16" steel
 (size) (material)
 - (6) pump 60 2000
 (HP) (yield gpm)
unif
 (type power)
 - (7) electric log no.
 (yes or no)

 (organization running log)
 - (8) how well bottom plugged steel plate


CODED

JUL 12 1972

DRILLERS REMARKS: _____

If well telescopes please sketch and show depths.

GROUND LEVEL

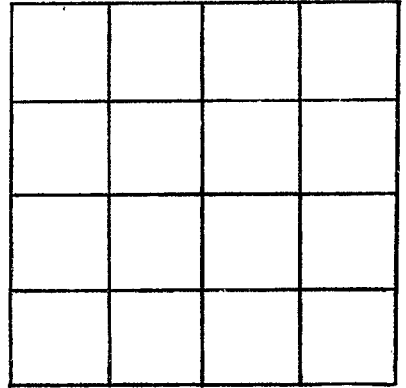

SECTION _____

Please indicate well location X.

ADDITIONAL INFORMATION

If more than one screen,
show locations of each on sketch.