

QUITMAN
H 37
1-15-73

MISSISSIPPI
BOARD OF WATER COMMISSIONERS
416 North State Street
Jackson, Mississippi 39201

CODED

WATER WELL DRILLERS LOG

June 5 1973 date well completed J B Carr firm name QUITMAN county well located

LANDOWNER: Helen [unclear] [unclear]
Crowder Miss

description of formations encountered	from	to
<u>Sand & Gravel</u>	<u>125</u>	<u>125</u>
<u>Blue Clay</u>	<u>125</u>	<u>460</u>
<u>Sand</u>	<u>460</u>	<u>500</u>

(mailing address)

WELL LOCATION:
sec. 11 T27 N R. 1 E
S. 2 K miles N of Crowder
(distance) (direction) (nearest town)

WELL PURPOSE: Rich Water
(home, irrigation, municipal, industrial)

WELL COMPLETION DATA:

(1) diameter (inches) 2"

(2) total depth (feet) 500

(3) static water level (feet) 2 ^{below}/_{above} top of ground.

(4) casing Plastic 500
(material) (depth)
(size) if telescope see back.

(5) screen 40 460
(length) (depth to top)
2" slot plastic
(size) (material)

(6) pump 27
(HP) (yield gpm)
(type power)

(7) electric log No
(yes or no)
(organization running log)

(8) how well bottom plugged Plug


CODED

DRILLERS REMARKS:

JUN 11 1973

If well telescopes please sketch and show depths.

GROUND LEVEL

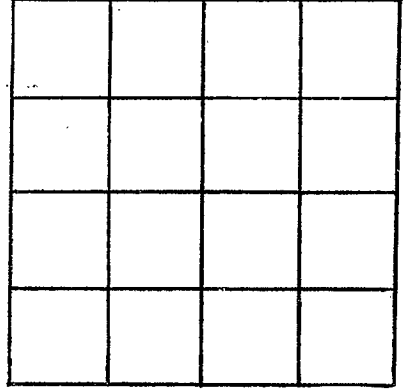

SECTION _____

Please indicate well location X.

ADDITIONAL INFORMATION

If more than one screen,
show locations of each on sketch.