

QUITMAN
H 43
8-25-76

MISSISSIPPI
 BOARD OF WATER COMMISSIONERS
 416 North State Street
 Jackson, Mississippi 39201

CODED

WATER WELL DRILLERS LOG

Aug 25 1976 North Miss Well Drilling Quitman
 date well completed firm name county well located


| LANDOWNER: | description of formations encountered | from | to |
|--|---------------------------------------|-----------|------------|
| <u>Cidney Guest</u> <u>Lambert</u> (mailing address) | | | |
| WELL LOCATION: sec. <u>27 T 27 N</u> R. <u>1 E</u> <u>1</u> miles <u>S</u> of <u>Lambert</u> (distance) (direction) (nearest town) | <u>Sand</u> | <u>18</u> | <u>35</u> |
| WELL PURPOSE: (home, irrigation, municipal, industrial) | <u>Red Gravel</u> | <u>55</u> | <u>100</u> |
| WELL COMPLETION DATA: | | | |
| (1) diameter (inches) <u>12"</u> | | | |
| (2) total depth (feet) <u>100</u> | | | |
| (3) static water level (feet) <u>12</u> below above top of ground. | | | |
| (4) casing <u>Steel</u> <u>100'</u> (material) (depth) | | | |
| (size) if telescope see back. | | | |
| (5) screen <u>48"</u> <u>✓</u> (length) (depth to top) | | | |
| <u>12</u> <u>stated</u> (size) (material) | | | |
| (6) pump <u>10"</u> <u>2500</u> (HP) (yield gpm) | | | |
| <u>Engine</u> <u>J.P. Yea</u> (type power) | | | |
| (7) electric log <u>No</u> (yes or no) | | | |
| (organization running log) | | | |
| (8) how well bottom plugged <u>Play</u> | | | |
| DRILLERS REMARKS: | | | |

RECEIVED
 SEP 27 1976

MISS. BD. OF WATER COMM.

If well telescopes please
sketch and show depths.

GROUND LEVEL

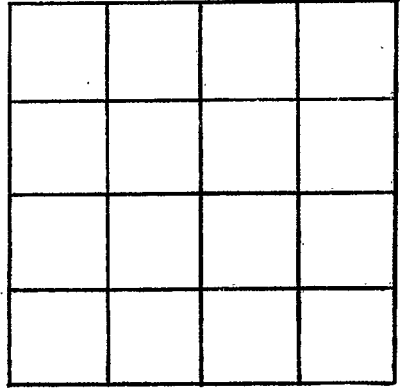

SECTION _____

Please indicate well location X.

ADDITIONAL INFORMATION

If more than one screen,
show locations of each on sketch.