

QUITMAN

H 44

9-9-77

MISSISSIPPI BOARD OF WATER COMMISSIONERS  
416 North State Street  
Jackson, Mississippi 39201

CODED

WATER WELL DRILLERS LOG

9-9

date well completed

19

77 Five Counties Farming Area

firm name

Quitman

county well located

LANDOWNER:

O. B. Sweet

description of formations encountered

from

to

Clay

0

19

Fine Sand

19

38

Medium Sand

38

58

Sand & Gravel

58

100

(mailing address)

WELL LOCATION:

sec. 35 T 34 N R 10 E  
1 1/2 mile miles SOUTH of Samburg  
(distance) (direction) (nearest town)

CODED

WELL PURPOSE:

(home, irrigation, municipal, industrial)

WELL COMPLETION DATA:

- (1) diameter (inches) 12"
- (2) total depth (feet) 100'
- (3) static water level (feet) 12' below top of ground.
- (4) casing PVC (material), 100' (depth), (size) If telescope see back.
- (5) screen 40' (length), 100' (depth to top), 12" 50/80 PVC (size), (material)
- (6) pump 40 (HP), 2200 (yield gpm), Diesel Power unit (type power)
- (7) electric log NO (yes or no)
- (organization running log)
- (8) how well bottom plugged PVC CAP

PROPERTY OF MISSISSIPPI BOARD OF WATER COMMISSIONERS


OCT - 5 1977

DRILLERS REMARKS:

MISS. Bd. of Water Comm.

If well telescopes please sketch and show depths.

GROUND LEVEL

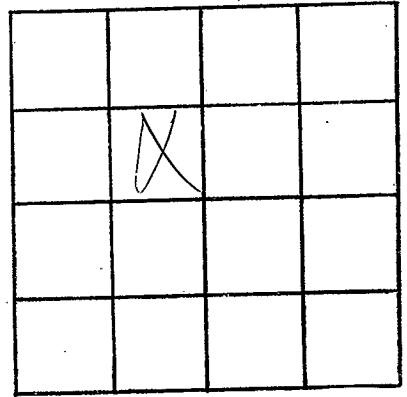

SECTION 35

Please indicate well location X.

ADDITIONAL INFORMATION

If more than one screen, show locations of each on sketch.