

QUITMAN
H 46
4-8-79

MISSISSIPPI
BOARD OF WATER COMMISSIONERS
416 North State Street
Jackson, Mississippi 39201

CODED

Quitman

WATER WELL DRILLERS LOG

4-8 1979 date well completed
Five Co. Foreman Bros firm name
Quitman county well located

LANDOWNER: Jack Butler
Mocha Min

description of formations encountered	from	to
top soil	0	14
fine sand	14	32
Coarse sand	32	44
road & bro	44	118

(mailing address)
WELL LOCATION:
sec 13 T27 N R 1 E
S W
2 miles east of Lambert
(distance) (direction) (nearest town)

CODED

WELL PURPOSE:
(home, irrigation, municipal, industrial)

- WELL COMPLETION DATA:
- (1) diameter (inches) 16"
 - (2) total depth (feet) 118
 - (3) static water level (feet) 17 below top of ground.
 - (4) casing steel, 63 (material) (depth)
(size) if telescope see back.
 - (5) screen 50' length, 63 (depth to top)
1 1/2" lowered steel (size) (material)
 - (6) pump 60 (HP) 3400 (yield gpm)
Electric (type power)
 - (7) electric log NO (yes or no)
 - (organization running log)
 - (8) how well bottom plugged welded

MISSISSIPPI BOARD OF WATER COMMISSIONERS


MAY - 7 1979

RECEIVED

DRILLERS REMARKS:

If well telescopes please sketch and show depths.

GROUND LEVEL

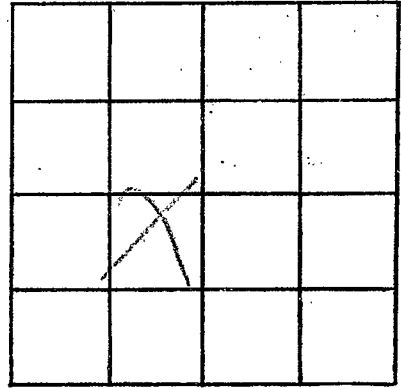

SECTION 13

Please indicate well location X.

ADDITIONAL INFORMATION

If more than one screen, show locations of each on sketch.