

QUITMAN
H-47
5--80

MISSISSIPPI
BOARD OF WATER COMMISSIONERS
416 North State Street
Jackson, Mississippi 39201

CODED

WATER WELL DRILLERS LOG

date well completed MAY 19 80 Pellets Road firm name QUITMAN county well located

LANDOWNER:	description of formations encountered	from	to
<u>Mrs. Lomer</u>			
<u>Lombert Mrs.</u> (mailing address)	<u>Clay</u>	<u>13</u>	<u>21</u>
	<u>Coarse sand + Gravel</u>	<u>21</u>	<u>62</u>
	<u>Coarse sand + Big gravel</u>	<u>62</u>	<u>116</u>
	<u>Set of</u>		<u>116</u>
WELL LOCATION:			
sec <u>20</u> T <u>27</u> N, R <u>1</u> E S W			
<u>3</u> miles west of <u>Lombert</u> (distance) (direction) (nearest town)			
WELL PURPOSE: <u>Domestic</u> (home, irrigation, municipal, industrial)			
WELL COMPLETION DATA:			
(1) diameter (inches) <u>12"</u>			
(2) total depth (feet) <u>116</u>			
(3) static water level (feet) <u>12 1/2</u> below top of ground.			
(4) casing <u>Steel</u> , <u>76</u> (material) (depth)			
(size) If telescope see back.			
(5) screen <u>40'</u> , <u>No</u> (length) (depth to top)			
<u>12"</u> , <u>Steel</u> (size) (material)			
(6) pump <u>30</u> , <u>1700</u> (HP) (yield gpm)			
<u>Y.P.</u> (type power)			
(7) electric log <u>No</u> (yes or no)			
(organization running log)			
(8) how well bottom plugged <u>Steel Beal</u>			
DRILLERS REMARKS:			

CODED

DEPT. OF NATURAL RESOURCES
BUREAU OF LAND & WATER RESOURCES

JUN 30 1980

RECEIVED

If well telescopes please sketch and show depths.

GROUND LEVEL

Wells Screen


12 1/2 ft.

12" Screen

5 ft 2

12" Screen

40'

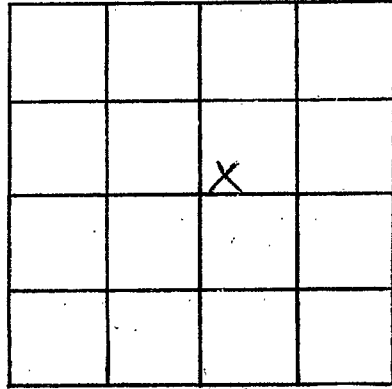

SECTION 20

Please indicate well location X.

ADDITIONAL INFORMATION

If more than one screen, show locations of each on sketch.