

Quitman
H 49
1-5-81

MISSISSIPPI
 BOARD OF WATER COMMISSIONERS
 416 North State Street
 Jackson, Mississippi 39201

WATER WELL DRILLERS LOG

1-15 1981 Finca Formosa Quitman
 date well completed firm name county well located

LANDOWNER: Danny Bushy
Lambert Miss
 (mailing address)

description of formations encountered	from	to
<u>Top clay</u>	<u>0</u>	<u>9</u>
<u>Fin sand</u>	<u>9</u>	<u>20</u>
<u>med sand</u>	<u>20</u>	<u>33</u>
<u>Coarse sand</u>	<u>33</u>	<u>56</u>
<u>Sand & gra</u>	<u>56</u>	<u>108</u>

WELL LOCATION:
 sec. 20 T 21 N R 1 E
S W
3 miles west of Lambert
 (distance) (direction) (nearest town)

WELL PURPOSE:
 (home, irrigation, municipal, industrial)

WELL COMPLETION DATA:

(1) diameter (inches) 12"

(2) total depth (feet) 100'

(3) static water level (feet) 13 below top of ground. above

(4) casing PVC, 60'
 (material) (depth)
12 if telescope see back.
 (size)

(5) screen 40', 60'
 (length) (depth to top)
12", PVC
 (size) (material)

(6) pump No pump installed
 (HP) (yield gpm)
 (type power)

(7) electric log no
 (yes or no)
 (organization running log)


(8) how well bottom plugged dog



DRILLERS REMARKS:

If well telescopes please sketch and show depths.

GROUND LEVEL

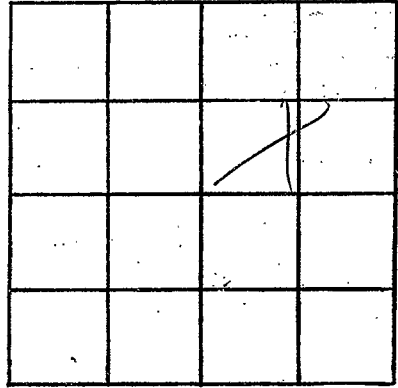

SECTION 20

Please indicate well location X.

ADDITIONAL INFORMATION

If more than one screen, show locations of each on sketch.