

Quitman  
H 50  
1-16-81

MISSISSIPPI  
BOARD OF WATER COMMISSIONERS  
416 North State Street  
Jackson, Mississippi 39201  
WATER WELL DRILLERS LOG

COPIED

1-16 1981 *Fire Co Farm Bldg* *Quitman*  
date well completed firm name county well located

LANDOWNER: *Denny Bayley*  
*Lambert Min*


description of formations encountered	from	to
<i>top clay</i>	<i>1</i>	<i>8</i>
<i>fine sand</i>	<i>8</i>	<i>19</i>
<i>med sand</i>	<i>19</i>	<i>34</i>
<i>coarse sand</i>	<i>34</i>	<i>59</i>
<i>sand &amp; gra</i>	<i>59</i>	<i>100</i>

(mailing address)

WELL LOCATION:  
sec *20* T *27* N R *1* E  
S *5* W *3*  
*3* miles *west* of *Lambert*  
(distance) (direction) (nearest town)

WELL PURPOSE:  
(home, irrigation, municipal, industrial)


- WELL COMPLETION DATA:
- (1) diameter (inches) *12"*
  - (2) total depth (feet) *100*
  - (3) static water level (feet) *13.6* below top of ground.
  - (4) casing *PVC* *100*  
(material) (depth)  
*12* if telescope see back.  
(size)
  - (5) screen *40'* *60'*  
(length) (depth to top)  
*12"* *PVC*  
(size) (material)
  - (6) pump *NO pump installed*  
(HP) (yield gpm)  
  
(type power)
  - (7) electric log \_\_\_\_\_  
(yes or no)  
  
(organization running log)
  - (8) how well bottom plugged *cap*

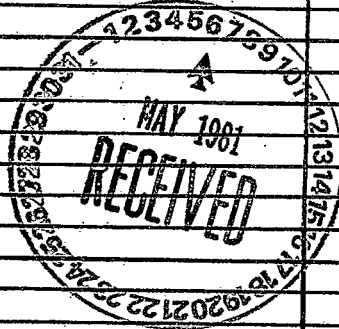

DRILLERS REMARKS:

If well telescopes please sketch and show depths.

GROUND LEVEL

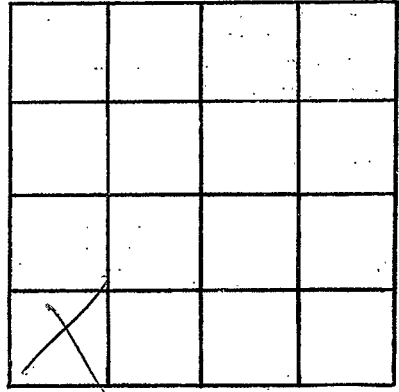

SECTION 21

Please indicate well location X.

ADDITIONAL INFORMATION

If more than one screen,  
show locations of each on sketch.