

MISSISSIPPI DEPARTMENT OF NATURAL RESOURCES

Bureau of Land and Water Resources

Southport Mall

P.O. Box 10631

Jackson, Mississippi 39209

WATER WELL DRILLERS LOG

8
COPIED

Quitman
H 51
4-20-81

4-20-81 19 N. Miss Well Drilling Quitman
date well completed firm name county well located

LANDOWNER: Leroy Reid
Lambert
(mailing address)


description of formations encountered	from	to
<u>Clay</u>	<u>0</u>	<u>18</u>
<u>Sand</u>	<u>18</u>	<u>60</u>
<u>Gravel</u>	<u>60</u>	<u>100</u>

WELL LOCATION:
sec. 6 T 22 N R 1 E
3 1/2 miles NW of Lambert
(distance) (direction) (nearest town)

WELL PURPOSE: IRrigation
(home, irrigation, municipal, industrial)

- WELL COMPLETION DATA:
- (1) diameter (inches) 10"
 - (2) total depth (feet) 100
 - (3) static water level (feet) 16 below above top of ground.
 - (4) casing Plastic 60
(material) (depth)
 - _____ if telescope see back.
(size)
 - (5) screen 40'
(length) (depth to top)
10" Slot Plastic
(size) (material)
 - (6) pump 20 Horse 1810
(HP) (yield gpm)
(Propane Power write)
(type power)
 - (7) electric log _____
(yes or no)


(organization running log)
 - (8) how well bottom plugged Cap

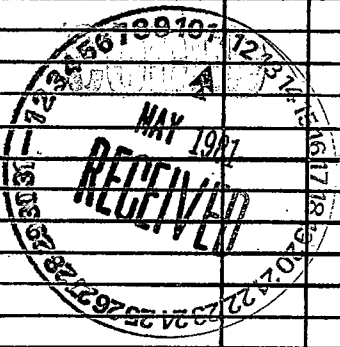

DRILLERS REMARKS: _____

If well telescopes please sketch and show depths.

GROUND LEVEL

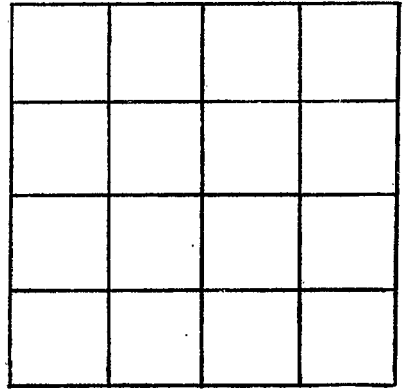

SECTION _____

Please indicate well location X.

ADDITIONAL INFORMATION

If more than one screen, show locations of each on sketch.