

Quitman  
H 52  
1-17-81

MISSISSIPPI  
 BOARD OF WATER COMMISSIONERS  
 416 North State Street  
 Jackson, Mississippi 39201

WATER WELL DRILLERS LOG

1-17-81 19 Five Co Farm Co Quitman  
 date well completed firm name county well located

76 east of Lambert.  
 This location about 5 pm SW of Lambert  
 May be 3 1/2 mi E of Walnut  
 450  
 R  
 Quad


LANDOWNER: Sarge Martin  
22 Sutherland Ave  
 (mailing address)

description of formations encountered	from	to
<u>top clay</u>	<u>0</u>	<u>7</u>
<u>fin sand</u>	<u>7</u>	<u>21</u>
<u>med sand</u>	<u>21</u>	<u>46</u>
<u>Coar sand &amp; grs</u>	<u>46</u>	<u>100</u>

WELL LOCATION: 27 N 1 W  
 sec 13 T 26 N R 2 E  
S W  
3 1/2 miles East of Lambert  
 (distance) (direction) (nearest town)

WELL PURPOSE:  
 (home, irrigation, municipal, industrial)

- WELL COMPLETION DATA:
- diameter (inches) 8"
  - total depth (feet) 100'
  - static water level (feet) 14 below top of ground.
  - casing PVC, 60' (material), (depth)  
8" (size) if telescope see back.
  - screen 40', 60' (length), (depth to top)  
8" (size), PVC (material)
  - pump 20 (HP), 1000 (yield gpm)  
Direct (type power)
  - electric log \_\_\_\_\_ (yes or no)
  - how well bottom plugged Cap

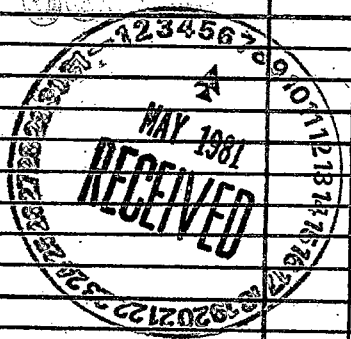

DRILLERS REMARKS:

If well telescopes please sketch and show depths.

GROUND LEVEL

X			
			E

SECTION 13

Please indicate well location X.

ADDITIONAL INFORMATION

If more than one screen,  
show locations of each on sketch.