

MISSISSIPPI DEPARTMENT OF NATURAL RESOURCES

Bureau of Land and Water Resources

Southport Mall

P.O. Box 10631

Jackson, Mississippi 39209

WATER WELL DRILLERS LOG CODED

0058

Quitman  
H53  
2-11-81

date well completed: 2/11 1981 firm name: Dyer county well located: Quitman

LANDOWNER:  
MAVIS COBB  
Lambert, MS.  
(mailing address)

WELL LOCATION:  
sec. 25 T. 27 N. R. 10 E  
4 miles S of Lambert  
(distance) (direction) (nearest town)

WELL PURPOSE: Irrigation  
(home, irrigation, municipal, industrial)

WELL COMPLETION DATA:

(1) diameter (inches) 16 1/2

(2) total depth (feet) 112

(3) static water level (feet) 20 below  
top of ground.

(4) casing Steel, 112  
(material) (depth)

16" if telescopic soo back.  
(size)

(5) screen 40, 72  
(length) (depth to top)

16" Steel  
(size) (material)

(6) pump 60 3000  
(HP) (yield gpm)


Diesel  
(type power)

(7) electric log \_\_\_\_\_  
(yes or no)


\_\_\_\_\_  
(organization running log)

(8) how well bottom plugged plate

description of formations encountered	from	to
soil	23	33
soil	33	43
soil	43	53
soil granite	53	63
soil gravel	63	73
soil granite	73	83
gravel	83	93
soil + gravel	93	103
gravel	103	112

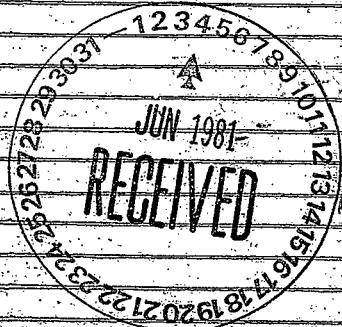

DRILLERS REMARKS:

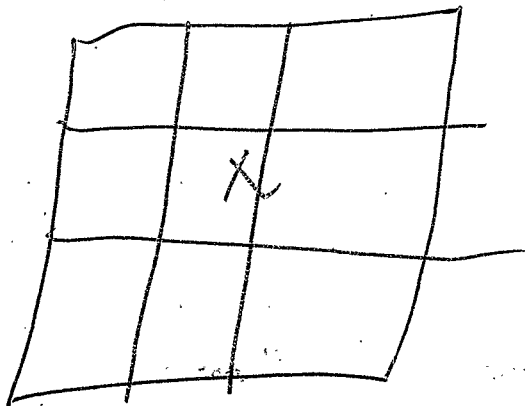

sec 35