

MISSISSIPPI DEPARTMENT OF NATURAL RESOURCES

Bureau of Land and Water Resources

Southport Mall

P.O. Box 10631

Jackson, Mississippi 39209

WATER WELL DRILLERS LOG CODED.

0047

Quitman  
H 54  
2-9-81

2/9 1981  
 date well completed

Dyer  
 firm name

Quitman  
 county well located

LANDOWNER:  
ROBERT MERHLE  
Lambert MS.  
 (mailing address)

WELL LOCATION:  
 sec 35 T 270 R 1 E  
3 S 3 miles S of Lambert  
 (distance) (direction) (nearest town)

WELL PURPOSE: Irrigation  
 (home, irrigation, municipal, industrial)

description of formations encountered	from	to
<u>sand</u>	<u>23</u>	<u>33</u>
<u>sand</u>	<u>33</u>	<u>43</u>
<u>sand</u>	<u>43</u>	<u>53</u>
<u>sand to gravel</u>	<u>53</u>	<u>63</u>
<u>gravel</u>	<u>63</u>	<u>73</u>
<u>sand to gravel</u>	<u>73</u>	<u>83</u>
<u>gravel</u>	<u>83</u>	<u>93</u>
<u>gravel</u>	<u>93</u>	<u>103</u>
<u>gravel</u>	<u>103</u>	<u>112</u>

WELL COMPLETION DATA:

(1) diameter (inches) 16

(2) total depth (feet) 112'

(3) static water level (feet) 20' below above top of ground.

(4) casing Steel 112'  
 (material) (depth)  
16" If telescopic see back.  
 (size)


(5) screen 40' 72'  
 (length) (depth to top)  
16" Steel  
 (size) (material)

(6) pump 60 3000  
 (HP) (yield gpm)  
electric  
 (type power)


(7) electric log \_\_\_\_\_  
 (yes or no)  
 (organization running log)

(8) how well bottom plugged plate

CODED

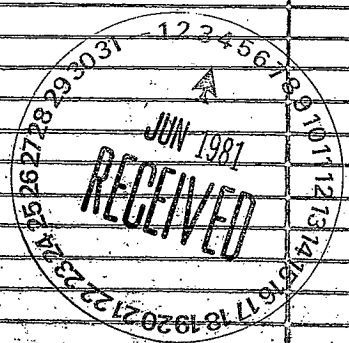

DRILLERS REMARKS:

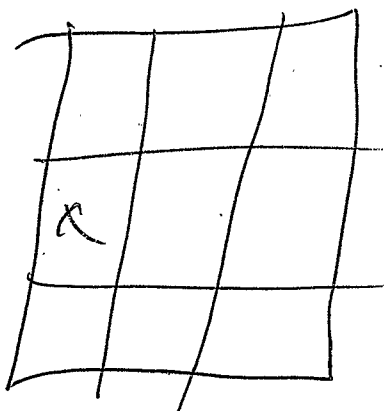

sec 35'