

MISSISSIPPI DEPARTMENT OF NATURAL RESOURCES

Bureau of Land and Water Resources

Southport Mall

P.O. Box 10631

Jackson, Mississippi 39209

WATER WELL DRILLERS LOG

CODED

Quetman  
H 55  
5-4-81

5-4-81 1981 Dyer Quetman  
 date well completed firm name county well located


LANDOWNER:	description of formations encountered	from	to
<u>Mainor Farms</u>	<u>Clay</u>	<u>0</u>	<u>18</u>
<u>Lumbert M.S.</u>	<u>Fine sand</u>	<u>18</u>	<u>44</u>
(mailing address)	<u>Sand &amp; gravel</u>	<u>44</u>	<u>113</u>

WELL LOCATION:  
 sec. 13 T 27 N R. 10 E  
4 miles E of LUMBERT  
 (distance) (direction) (nearest town)

WELL PURPOSE: irrigation  
 (home, irrigation, municipal, industrial)

- WELL COMPLETION DATA:
- (1) diameter (inches) 16"
  - (2) total depth (feet) 113'
  - (3) static water level (feet) 18 below above top of ground.
  - (4) casing Steel, 113',  
 (material) (depth)  
16" if telescope see back.  
 (size)
  - (5) screen 40', 73'  
 (length) (depth to top)  
16", Steel  
 (size) (material)
  - (6) pump 60, 3000  
 (HP) (yield gpm)  
 \_\_\_\_\_  
 (type power)
  - (7) electric log \_\_\_\_\_  
 (yes or no)  
 \_\_\_\_\_  
 (organization running log)
  - (8) how well bottom plugged plate

CODED

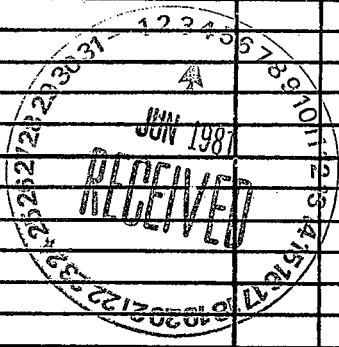

DRILLERS REMARKS:

If well telescopes please sketch and show depths.

GROUND LEVEL

X			

SECTION 13

Please indicate well location X.

ADDITIONAL INFORMATION

If more than one screen,  
show locations of each on sketch.