

MISSISSIPPI DEPARTMENT OF NATURAL RESOURCES

Bureau of Land and Water Resources

Southport Mall

P.O. Box 10631

Jackson, Mississippi 39209

WATER WELL DRILLERS LOG


CODED

Quitman
H 56
4-31-81

4-31-1981 Dyer Quitman
 date well completed firm name county well located


LANDOWNER:	description of formations encountered	from	to
<u>Trainer Farms</u> <u>Lambert, MS.</u> (mailing address)			
	<u>fine sand</u>	<u>18</u>	<u>58</u>
	<u>sand & gravel</u>	<u>58</u>	<u>113</u>
WELL LOCATION:			
sec. <u>24</u> T. <u>27</u> N. R. <u>10</u> E. S. <u>4</u> W.			
<u>4</u> miles <u>E</u> of <u>LAMBERT</u> (distance) (direction) (nearest town)			
WELL PURPOSE: <u>Irrigation</u> (home, irrigation, municipal, industrial)			
WELL COMPLETION DATA:			
(1) diameter (inches) <u>16"</u>			
(2) total depth (feet) <u>113'</u>			
(3) static water level (feet) <u>19'</u> below above top of ground.			
(4) casing <u>Steel</u> , <u>113'</u> (material) (depth) <u>16"</u> if telescope see back. (size)			
(5) screen <u>40'</u> , <u>73'</u> (length) (depth to top) <u>16"</u> , <u>Steel</u> (size) (material)			
(6) pump <u>60</u> , <u>3000</u> (HP) (yield gpm) <u>Propane</u> (type power)			
(7) electric log _____ (yes or no) (organization running log)			
(8) how well bottom plugged <u>plate</u>			
DRILLERS REMARKS:			

CODED

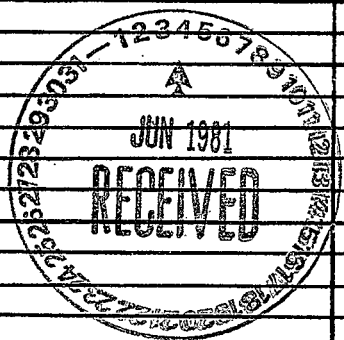

If well telescopes please sketch and show depths.

GROUND LEVEL

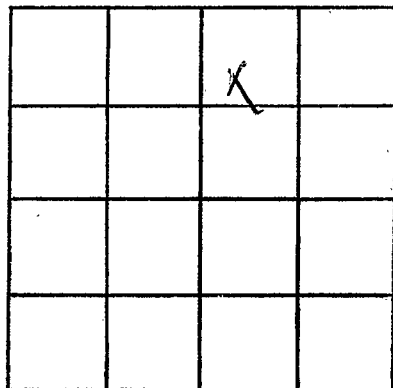

SECTION 24

Please indicate well location X.

ADDITIONAL INFORMATION

If more than one screen,
show locations of each on sketch.