

MISSISSIPPI DEPARTMENT OF NATURAL RESOURCES

Bureau of Land and Water Resources

Southport Mall

P.O. Box 10631

Jackson, Mississippi 39209

WATER WELL DRILLERS LOG

CODED

Quitman
H/57
4-18-81

4-18- 19 81

Dyer
 firm name

Quitman
 county well located

LANDOWNER:
Joel Bailey
Lambert, MS.
 (mailing address)

description of formations encountered	from	to
<u>Clay</u>	<u>0</u>	<u>26</u>
<u>Fine sand</u>	<u>26</u>	<u>41</u>
<u>Sand & gravel</u>	<u>41</u>	<u>113</u>

WELL LOCATION:
 sec 26 T 27 N R 10 E
 S W
6 miles SE of LAMBERT
 (distance) (direction) (nearest town)

WELL PURPOSE: Irrigation
 (home, irrigation, municipal, industrial)

CODED

WELL COMPLETION DATA:

(1) diameter (inches) 16"

(2) total depth (feet) 113'

(3) static water level (feet) 21 below above top of ground.

(4) casing Steel 113'
 (material) (depth)
16" if telescope see back.
 (size)


(5) screen 40' 73'
 (length) (depth to top)
16" Steel
 (size) (material)

(6) pump 60 3000
 (HP) (yield gpm)
Diesel
 (type power)

(7) electric log _____
 (yes or no)

 (organization running log)


(8) how well bottom plugged plate

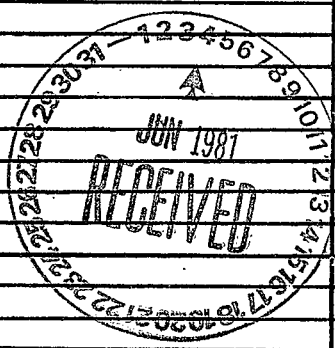

DRILLERS REMARKS:

If well telescopes please sketch and show depths.

GROUND LEVEL

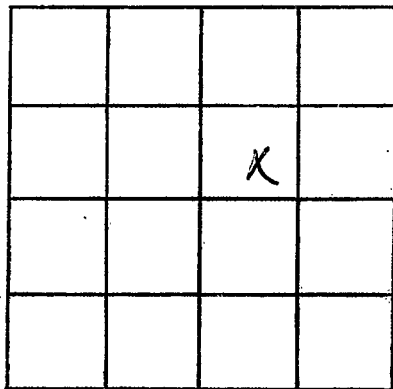

SECTION 36

Please indicate well location X.

ADDITIONAL INFORMATION

If more than one screen, show locations of each on sketch.