

MISSISSIPPI DEPARTMENT OF NATURAL RESOURCES
 Bureau of Land and Water Resources
 Southport Mall
 P.O. Box 10631
 Jackson, Mississippi 39209
WATER WELL DRILLERS LOG

CODED

Quitman
H58
2-2-81

7-7-81 19 Five Co. Formers Quitman
 date well completed firm name county well located


LANDOWNER: Cobb & Shillman
Samba mine
 (mailing address)
 WELL LOCATION:
 sec. 18 T. 27 N. R. 1 E.
4 miles EAST of Lambert
 (distance) (direction) (nearest town)

description of formations encountered	from	to
<u>top clay</u>	<u>0</u>	<u>8</u>
<u>Fine sand</u>	<u>8</u>	<u>22</u>
<u>Coarse sand</u>	<u>22</u>	<u>39</u>
<u>Fine sand</u>	<u>39</u>	<u>48</u>
<u>Coarse sand & pea gra.</u>	<u>48</u>	<u>90</u>
<u>Big gra.</u>	<u>90</u>	<u>110</u>

WELL PURPOSE:
 (home, irrigation, municipal, industrial)

WELL COMPLETION DATA:
 (1) diameter (inches) 16"
 (2) total depth (feet) 110'
 (3) static water level (feet) 142 below above top of ground.
 (4) casing Steel 60
 (material) (depth)
16" if telescope see back.
 (size)
 (5) screen 50' 60'
 (length) (depth to top)
16" Browns-Steel
 (size) (material)
 (6) pump 300 3000
 (HP) (yield gpm)
Clear
 (type power)
 (7) electric log no
 (yes or no)
 (organization running log)
 (8) how well bottom plugged wehled

CODED

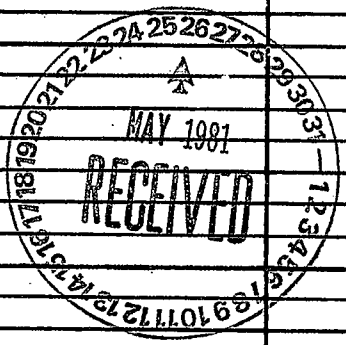

DRILLERS REMARKS:

If well telescopes please sketch and show depths.

GROUND LEVEL

SECTION 18

Please indicate well location X.

ADDITIONAL INFORMATION

If more than one screen, show locations of each on sketch.