

MISSISSIPPI DEPARTMENT OF NATURAL RESOURCES

Bureau of Land and Water Resources

Southport Mall

P.O. Box 10631

Jackson, Mississippi 39209

WATER WELL DRILLERS LOG

CODED

QUITMAN
H 60

7-85 19

Powell IRR

Quitman

date well completed

firm name

county well located

LANDOWNER:
A.C. ACKINSON
Batesville, MS
(mailing address)

description of formations encountered

from

to

Clay	0	13
COARSE SAND	13	40
GRAVEL	40	95

WELL LOCATION:
sec. 3 T 21 N R 1 E
6 miles W of MARKS
(distance) (direction) (nearest town)

CODED

WELL PURPOSE: IRR
(home, irrigation, municipal, industrial)


WELL COMPLETION DATA:

- (1) diameter (inches) 12
- (2) total depth (feet) 95
- (3) static water level (feet) 15 below above top of ground.
- (4) casing Steel, 55 (material) (depth), 12 (size) if telescope see back.
- (5) screen 40, 55 (length) (depth to top), 12 (size), Steel (material)
- (6) pump 60 1500 (HP) (yield gpm)
Diesel (type power)
- (7) electric log No (yes or no)

(organization running log)

(8) how well bottom plugged Steel PLATE

DRILLERS REMARKS:

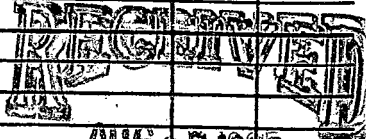

AUG 7 1985

Department of Natural Resources
Bureau of Land and Water

