

Part 2 never received 4/13 State Well Report

County: Quitman  
 Permit #: \_\_\_\_\_  
 Driller: Willie L. Bryant  
 Date drilling completed: 2-25-06

Part 1  
 Mississippi Department of Environmental Quality  
 Office of Land and Water Resources  
 P.O. Box 10631  
 Jackson, MS 39289-0631  
 (601)961-5210  
 (601)354-6938 (fax)

For Office Use Only:  
 Aquifer: \_\_\_\_\_  
 Well #: H-138  
 L. S. Elevation: \_\_\_\_\_  
 E-log #: \_\_\_\_\_

State Law requires that this report be prepared by the driller in detail and filed with the Department within 30 days of completion of drilling of the well.

Well Owner Information	Well Location
Owner Name: <u>Clarence McCullar</u>	Latitude: <u>34° 12' 83" N</u> Longitude: <u>090° 16' 15" W</u>
Mailing Address: <u>775 Butler Rd.</u>	Method of Lat/Long (circle one): <u>Hand-held GPS</u> Conventional Survey
<u>Lambert MS 38643</u>	USGS quad, <u>SE 1/4 NW 1/4 Sec 14 Twn 27N Rng 1W</u>
City State Zip Code	Distance <u>2 1/4</u> Miles Direction <u>NE</u> of Nearest Town <u>Lambert</u>
Telephone No. <u>(662) 326-2049</u>	

**Well Data**

Purpose of Well (circle one) Home Industrial Public Supply Irrigation Fish Culture Other: \_\_\_\_\_

Date well drilling started: 2-25-06 Date well drilling completed: 2-25-06

If flowing, method of flow regulation: Valve \_\_\_\_\_ Other (describe) ~~2-26-06~~

Static Water Level: 15 feet above or below (circle one) land surface Date measured: 2-26-06

Method of Measurement (circle one) steel tape electric tape air line other: Rope & weight

Hole depth: 102' Well depth: 100' Well grouted to a depth of 12 feet

Type of grout (circle one): Cement Bentonite Mix

Casing length: 90 feet Casing diameter: 4 inches Type of casing: PVC 160

Screen length: 10 feet Screen diameter: 4 inches Type of screen: PVC SCH 40

Screen slot size: .013 inches Setting depth: From 90 feet to 100 feet

Type of completion (circle all applicable): Gravel packed Underreamed Telescoped Open hole Natural Development

Other (describe): \_\_\_\_\_

Top of lap pipe or reduction in casing: 0 feet. If telescoped or more than one screen, describe on back of page

Logs run (circle all applicable): No log run Electric Gamma Ray Density Sonic Neutron Other: \_\_\_\_\_

Name of organization running log(s): \_\_\_\_\_

I certify that the well was drilled, constructed, and completed in accordance with all applicable requirements of the Mississippi Department of Environmental Quality and/or the Mississippi Department of Health regulations and state laws.

Willie L. Bryant 0-639  
 Print Name of Water Well Contractor and License No.

Willie L. Bryant  
 Signature of Water Well Contractor

Drilled For: Luckett Pump + Well Dublin, MS

RECEIVED  
 MAR 10 2006  
 BY: OLWR

H-138


If well telescopes please sketch below and show depths.

Ground Level \_\_\_\_\_

Description of Formations Encountered	From	To
Top Soil & Clay	0	20
Clay	20	40
Clay & Fine Sand	40	60
Med. Sand	60	80
Med. Sand & Gravel	80	100

If more than one screen, show location of each on sketch

Sketch the property layout and include the following: 1) the well location; 2) any permanent structures on the property that may aid in locating the well; 3) any roads, power lines, or other items that may aid in locating the property and the well; 4) indicate direction.

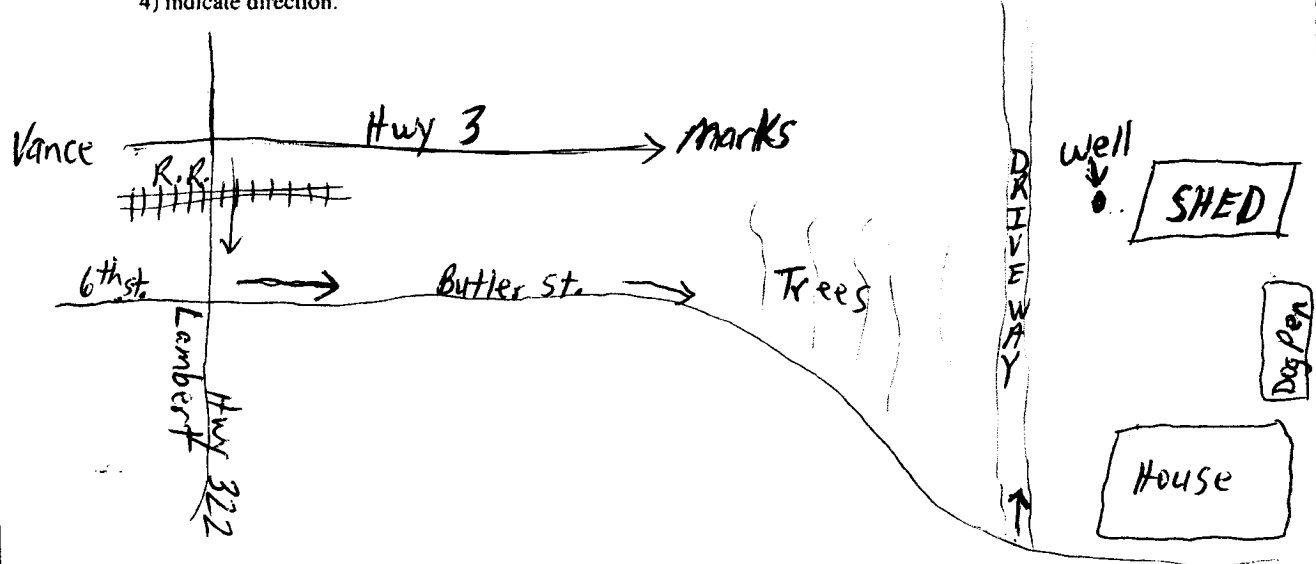

Landowner Name: Clarence Mc Cullan

Willie L. Bryant  
Signature of Water Well Contractor

**RECEIVED**  
MAR 10 2006  
**BY: OLWR**