

Part 2 never received 4/13

State Well Report Part I - Driller's Log

Mississippi Department of Environmental Quality
Office of Land and Water Resources
P.O. Box 2307
Jackson, MS 39225
(601)961-5210
(601)961-5228 (fax)

County: Quitman
 Permit #: GW42964
 Driller: Pete Sappington
 Date drilling completed: 11-25-08

For Office Use Only:
 Aquifer: _____
 Well #: H-144
 L. S. Elevation: _____
 E-log #: _____

State Law requires that this report be prepared by the license holder responsible for the work and filed with the Department at the above address within 30 days of completion of drilling of the well or borehole.

Information on Well Owner (Landowner if borehole is not for a water well) Owner Name: <u>Campbell Bros. Farms</u> Mailing Address: <u>2970 Big Creek Rd.</u> <u>Clarksdale MS 38614</u> City State Zip Code Telephone No. (<u>662</u>) <u>627-2703</u>		Well or Borehole Location Latitude: <u>34° 12' 47.07"</u> Longitude: <u>90° 16' 07"</u> Method of Lat/Long (circle one): <u>Hand-held GPS</u> Conventional Survey USGS quad, <u>Hand-held GPS</u> Survey-grade GPS <u>SE 1/4 NW 1/4 Sec 14 Twp 27N Rng 1W</u> Distance Direction Nearest Town <u>1/2</u> Miles <u>E</u> of <u>Lambert</u>	
---	--	--	--

Well / Borehole Data

Date drilling started: 11-25-08 Date drilling completed: 11-25-08 Hole depth: 100' Hole diameter: 28"

Location of the source of any surface water used for drilling: Slough next to well site
 Method of dosing and volume of Chlorine used in drilling and development: Sodium hypochlorite @ 10 ppm

Logs run (circle all applicable): No log run Electric Gamma Ray Density Sonic Neutron Other: _____
 Name of organization running log(s): _____

Purpose of borehole (check one): Water Well Geotechnical/Geological Investigation _____ Ground Source Heat Pump _____
 Seismic Survey _____ Other (describe) _____

If drilling is not related to water well construction, skip the remainder of this block

Purpose of Well (check one): Home _____ Industrial _____ Public Supply _____ Irrigation _____ Fish Culture Other: _____

If a flowing well, method of flow regulation: Valve _____ Other (describe) _____

Static Water Level: 10 feet above or below (circle one) land surface Date measured: 11-25-08

Method of Measurement (circle one) steel tape electric tape air line other: _____

Well depth: 100 Well grouted to a depth of 10 feet Type of grout (circle one): Neat Cement Bentonite Mix

Casing length: 60 feet Casing diameter: 16 inches Type of casing: PVC

Screen length: 40 feet Screen diameter: 16 inches Type of screen: PVC

Screen slot size: .032 inches Setting depth: From 60 feet to 100 feet

Type of completion (circle all applicable): Gravel packed Underreamed Telescoped Open hole Natural Development
 Other (describe): _____

Top of lap pipe or reduction in casing: _____ feet. *If telescoped or more than one screen, describe on next page*

H38

Pete Sappington


Form: OLWR-SWR-1A (04/08)

RECEIVED
DEC 22 2008
BY: OLWR

H-144

The sketch below only required for water wells

If well telescopes, show depths on sketch.

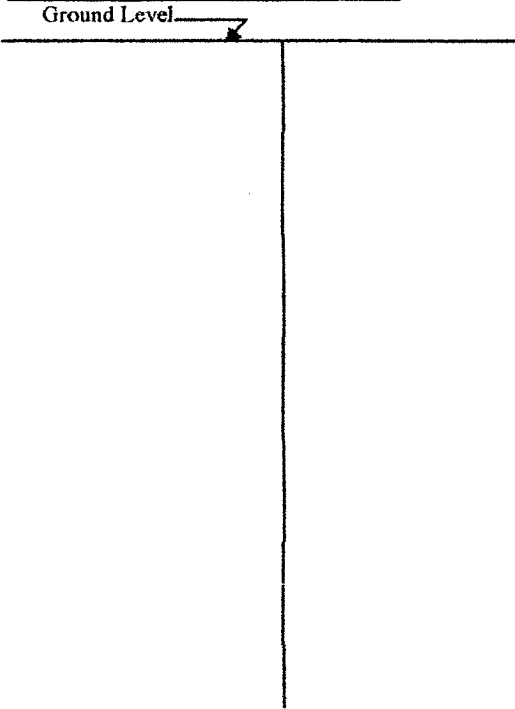

Description of formations encountered must be provided for all wells and boreholes, unless specifically exempted by regulations

Description of Formations Encountered	From (depth)	To (depth)
Mud Clay	Ground Level	20
Fine Sand	20	50
Coarse Sand/Gravel	50	100

If more than one screen, show location of each on sketch

Sketch the property layout and include the following: 1) the well location; 2) any permanent structures on the property that may aid in locating the well; 3) any roads, power lines, or other items that may aid in locating the property and the well; 4) a north arrow.

Landowner Name: Campbell Farms

Form: OLWR-SWR-1A (04/08)

I certify that the well/borehole was drilled, constructed, and completed in accordance with all applicable requirements of the Mississippi Department of Environmental Quality and the Mississippi Department of Health regulations, if applicable, and state laws.

Pete Sappington #0430 12-6-08
 Print Name of Responsible Licensee and License No. Date

Pete Sappington
 Signature of Licensee

RECEIVED
 DEC 22 2008
 BY: OLWR