	STATE WELL REPORT	For Offi
County: Quitman	Part 1	Well #:
Permit #: GW-49763	Driller's Log	Aquifer:
Driller: Irrigation Equipment, Inc.	Mississippi Department of Environmental Quality Office of Land and Water Resources	E-Log #:
Date drilling completed: 2-1-17	P.O. Box 2309 Jackson, MS 39225-2309 (601) 961-5210	

For Office Use Only:			
Well #:	H160		
Aquifer:			
E-Log #:			

(601) 360-0535 (fax) State Law requires that this report be prepared by the license holder responsible for the work and filed with the Department at the above address within 30 days of completion of drilling of the well or borehole. **Well Owner Information** Well or Borehole Location (Landowner if borehole is not for a water well) Latitude: 34° 14' 03.8" Longitude: 090° 18' 05.5" Owner Name: Zepponi Planting Company Mailing Address: 7 Neil Cove Method of Lat/Long (check one):

Conventional Survey, ☐ USGS quad, ☐ Hand-held GPS, ☐ Survey-grade GPS SW 1/4 SE 1/4, Sec 4 T 27N R 1W 38626 MS Dundee City State Zip code West (Direction) Telephone No. Well / Borehole Data Date drilling started: 2-1-17 Date drilling completed: 2-1-17 Hole depth: 115' Hole diameter: 24" Location of the source of any surface water used for drilling: Surface Water 50 PPM Method of dosing and volume of Chlorine used in drilling and development: Logs run (check all applicable): ⊠ No log run 🗌 Electric 🔲 Gamma Ray 🔲 Density 🔲 Sonic 🦳 Neutron 🗍 Other: Name of organization running log(s): Purpose of borehole (check one): 🛛 Water Well 🔲 Geotechnical/Geological Investigation 🖂 Ground Source Heat Pump Other (describe) ☐ Seismic Survey If drilling is not related to water well construction, skip the remainder of this block Purpose of Well (check all applicable): ☐ Home ☐ Industrial ☐ Public Supply ☒ Irrigation ☐ Fish Culture ☐ Other (describe): If a flowing well, method of flow regulation: Valve ______ Other (describe) _ feet [☐ above or ☒ below] land surface Date measured: 2-2-17 (check one) Method of Measurement (check one) ⊠ Steel tape ☐ Electric tape ☐ Air line ☐ Other: (describe) Well depth: 115' Well grouted to a depth of: 10 feet Type of grout (check one): ☐ Neat Cement ☒ Bentonite ☐ Mix feet Casing diameter: 16 Casing length: 75 inches Type of casing: PVC Screen length: 40 feet Screen diameter: 16 Type of screen: PVC inches Setting depth: From 68 Screen slot size: .050 feet to 107 inches Type of completion (check all applicable): ⊠ Gravel packed □ Underreamed □ Open hole □ Natural Development □ CEIV □ D ☐ Other (describe): Top of lap pipe or reduction in casing: Feet

If telescoped or more than one screen, describe on next page

Form: OLWR-SWR-1A (4/13)

County: Quitman Permit #: GW-49763			For Office Use of Well-#: H\60	Only:
The sketch below only required	·	<u>Description of formations encounant boreholes, unless specifically</u>		<u>ll wells</u>
If well telescopes, show depths of	on sketch.	Description of Formations From	tarad Francidanth)	T- /d4h\
Ground level —		Description of Formations Enco	ountered From (depth) Ground level	To (depth) 53
		Fine Sand	54	64
		Med. Sand & Gravel	65	106
		Fine Sand	107	115
,				
If more than one screen, show	l w location of each on sketch			
the well location any permanent str	t and include the following: uctures on the property that may lines, or other items that may aid	aid in locating the well in locating the property and the v	vell	
		de constitución de la constitución de constitu	RECEIVED	
			FEB 14 2017	
			BYOLWR	
Landowner Name:		•		i
requirements of the Missis if applicable, and state law	the well/borehole was drilled, con ssippi Department of Environment /s.	al Quality and the Mississippi De	dance with all applicable	SWR-1A (04/08) ons,
0695 Print Name of Responsible	le Licensee and License No.	2-3-17 \ \ \ \ \ \ \ \ \ \ \ \ \ \ \ \ \ \ \	Signature of Licenses	
Finit Name of Responsible	ie Licensee and License No.	Dale ,	Signature of Licensee Form: OLWR-SW	/R-1A (4/13)

STATE WELL REPORT

County: QUITMAN Permit #: GW. 49763 Driller: Issign Fquipment Date completed: 2-1-17 Copy information from block on Part 1

Part 2


Pump Installer's Completion Report
Mississippi Department of Environmental Quality
Office of Land and Water Resources
P.O. Box 2309

Jackson, MS 39225-2309 (601)961-5210 (601) 360-0535 (fax)

For (Office Use Only:
Well #:	H160
Aquifer:	

This part of the report must be completed by a licensed water well contractor or a licensed pump installer. A copy of Part 1 of the report must be attached and both parts filed with the Department at the above address within 30 days of well completion				
Well Owner Information Well Location				
Owner Name: ZEMONI PLANTING Co Latitude: 340/4. 38"Longitude: 900 18.5.5"				
Mailing Address:				
USGS quad, Hand-held GPS, Survey-grade GPS				
Du NOSS MS 323626 SW 14 SE 14, Sec 4 T 27N R /W City State Zip Code // City State Zip Code				
Telephone No. (42) 627-1377 Zip Code (Distance) (Direction) (Nearest Town)				
Telephone No. (42) 627-1377 Logistance) SW of MARKS (Direction) (Nearest Town)				
Pump Type (circle one)				
Submersible Turbine Air Lift Centrifugal Flowing Well Jet Piston Rotary Other (describe):				
Date Pump Installed: 3-1-17 Rated Pump Capacity: 2100 Gallons Per Minute				
Is This Pump (circle one): (New) Repaired Replacement				
Power Type (circle one)				
Electric Diesel Gasoline Natural Gas Tractor PTO Windmill Other (describe):				
Horse Power Rating of Motor: 60 Setting Depth: 70 feet Number of Stages: 1				
Pump Test Data for Non Flowing Well				
Date Well Tested: Duration of Pump Test (minimum 4 hours): hours				
Static Water Level (A): Feet Below Land Surface Pumping Water Level (B): Feet Below Land Surface				
Drawdown [(B) - (A)]:Feet Below Land Surface Test Pumping Rate: Gallons Per Minute				
Method of measurement (circle one): Steel tape Electric tape Air line Other (describe):				
Pump Test Data for Flowing Well				
Measured shut in head:feet.				
Well yieldedGPM with a drawdown offeet afterhours of pumping				
Meter Installation				
Meter Manufacturer: Meter Serial Number:				
Meter Model Number/Name: Type of Meter:				
Totalizer Register Unit and Multiplier Factor (AF x .001, gal x 1000, etc):				
Installation Date: Meter installed by: RECEIVED				
Installation Date: Meter installed by: Meter installed by:				
Important: By submitting the above information you are certifying that this meter was installed to manufacturer standards. For agricultural wells, a list of approved meters is on the MDEQ website.				
I HEREBY CERTIFY that the above statements are true to the best of my knowledge.				
DAVED 2 HOUT 0-2522 22517 (- 1)				
Print Name of Pump Installer and License No. (if applicable) 3.25-17 Signature of Pump Installer				
Jighacute of Lump instance and Elective not (i) approaches				

Form: OLWR-SWR-1B (4/13)

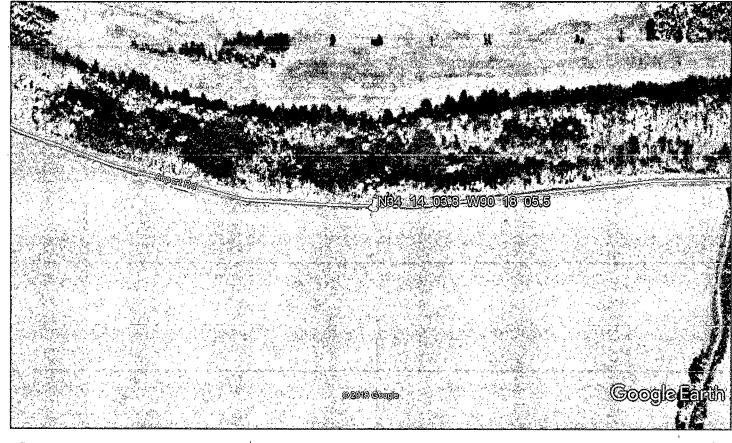

Google Earth

feet 1000 meters 500

RECEIVED FEB 14 2017 BY OLWR

STATE OF MISSISSIPPI

Department of Environmental Quality Office of Land and Water Resources P. O. Box 2309 Jackson, Mississippi 39225

PERMIT -

TO DIVERT OR WITHDRAW FOR BENEFICIAL USE THE PUBLIC WATERS

This permit is issued to the landowner named below in accordance with the provisions of the Mississippi Water Laws, Mississippi Code Sections 51-3-1, et seq.(1972, as amended), and the regulations and standards as promulgated thereunder. Whether or not specifically named in this permit or in the applications for this permit, anyone using water from the diversion/withdrawal point described below shall do so in compliance with the provisions of this permit. Neither this permit, nor any authority conferred hereby, may be sold, conveyed, encumbered, assigned, or otherwise aliened, for any period of time or under any conditions whatsoever. This permit may not be modified, transferred or revoked without prior action by the Permit Board. Any attempts to modify, transfer or revoke this permit, or to take any other action on this permit, shall be invalid and unenforceable and may result in immediate revocation or suspension of this permit. The holder of this permit shall at all times be responsible for adherence to the terms and conditions of this permit. No agreement between the permit holder and any other party shall affect the obligations and liabilities of the permit holder. Water use under this permit is allowed only when the streamflow, lake level elevation, or static groundwater level (whichever, if any, is applicable) is above the established minimum, pursuant to Mississippi Code Section 51-3-7. Authorization is hereby granted to divert/withdraw water for the beneficial use designated herein, and for no other purpose, subject to the following terms, conditions, and limitations:

Permit Number: MS-GW-49763

Landowner Name: ZEPPONI PLANTING COMPANY

Landowner Address: 7 NEIL COVE

DUNDEE

38626 MS

Source Of Water: MISSISSIPPI RIVER VALLEY ALLUVIAL AQUIFER

Beneficial Use: IRRIGATION

Diversion/Withdrawal Location: SW 1/4 of the SE 1/4

Section: 04

Township:27N

Range: 01W

County: QUITMAN

Quad: LAMBERT

Maximum Volume: 267 Acre-Feet/Year

equivalent to .2383

Million Gallons/Day

Maximum Rate: 2100 Gallons/Minute

Applicant Name: ZEPPONI PLANTING COMPANY

DUNDEE

Applicant Address: 7 NEIL COVE

38626 MS

FFB 14 2017

RYOLWR

Date Permit Issued: 12/15/2016 Date Permit Expires: 12/15/2021

Date Permit Modified:

Date Permit Re-issued:

This permit shall be deemed null and void if construction has not begun within one (1) year of permit issue date

SPECIAL TERMS AND CONDITIONS: SEE ATTACHMENT 1, WHICH IS HEREBY DECLARED TO BE PART OF THIS PERMIT.

SPECIAL TERMS AND CONDITIONS 2:

Gary C. Rikard, Executive Director

Mississippi Department of Environmental Quality