

F2

County: Quitman  
 Permit #: GW-49764 ✓  
 Driller: Irrigation Equipment, Inc.  
 Date drilling completed: 2-2-17

# STATE WELL REPORT

## Part 1

### Driller's Log

Mississippi Department of Environmental Quality  
 Office of Land and Water Resources  
 P.O. Box 2309  
 Jackson, MS 39225-2309  
 (601) 961-5210  
 (601) 360-0535 (fax)

**For Office Use Only:**  
 Well #: H161  
 Aquifer: \_\_\_\_\_  
 E-Log #: \_\_\_\_\_

*State Law requires that this report be prepared by the license holder responsible for the work and filed with the Department at the above address within 30 days of completion of drilling of the well or borehole.*

Well Owner Information <i>(Landowner if borehole is not for a water well)</i>	Well or Borehole Location
Owner Name: <u>Zeponi Planting Company</u>	Latitude: <u>34° 14' 05.3"</u> Longitude: <u>090° 17' 45.7"</u>
Mailing Address: <u>7 Neil Cove</u>	Method of Lat/Long (check one): <input type="checkbox"/> Conventional Survey, <input type="checkbox"/> USGS quad, <input checked="" type="checkbox"/> Hand-held GPS, <input type="checkbox"/> Survey-grade GPS
<u>Dundee</u> <u>MS</u> <u>38626</u> City State Zip code	<u>SE</u> ¼ <u>SE</u> ¼, Sec <u>4</u> T <u>27N</u> R <u>1W</u>
Telephone No. <u>( ) -</u>	<u>      </u> Miles <u>West</u> of <u>      </u> Marks <i>(Distance) (Direction) (Nearest Town)</i>

**Well / Borehole Data**

Date drilling started: 2-2-17 Date drilling completed: 2-2-17 Hole depth: 117' Hole diameter: 24"

Location of the source of any surface water used for drilling: Surface Water

Method of dosing and volume of Chlorine used in drilling and development: 50 PPM

Logs run (check all applicable):  No log run  Electric  Gamma Ray  Density  Sonic  Neutron  Other: \_\_\_\_\_

Name of organization running log(s): \_\_\_\_\_

Purpose of borehole (check one):  Water Well  Geotechnical/Geological Investigation  Ground Source Heat Pump  
 Seismic Survey  Other (describe) \_\_\_\_\_

*If drilling is not related to water well construction, skip the remainder of this block*

Purpose of Well (check all applicable):  Home  Industrial  Public Supply  Irrigation  Fish Culture  
 Other (describe): \_\_\_\_\_

If a flowing well, method of flow regulation: Valve \_\_\_\_\_ Other (describe) \_\_\_\_\_

Static Water Level: 25 feet [ above or  below] land surface Date measured: 2-2-17  
*(check one)*

Method of Measurement (check one)  Steel tape  Electric tape  Air line  Other: (describe) \_\_\_\_\_

Well depth: 117' Well grouted to a depth of: 10 feet Type of grout (check one):  Neat Cement  Bentonite  Mix

Casing length: 77 feet Casing diameter: 16 inches Type of casing: PVC

Screen length: 40 feet Screen diameter: 16 inches Type of screen: PVC

Screen slot size: .050 inches Setting depth: From 78 feet to 117 feet

Type of completion (check all applicable):  Gravel packed  Underreamed  Open hole  Natural Development  
 Other (describe): \_\_\_\_\_

Top of lap pipe or reduction in casing: \_\_\_\_\_ Feet

*If telescoped or more than one screen, describe on next page*

RECEIVED

FEB 14 2017

Form: OLWR-SWR-1A (4/13)

BY OLWR



# STATE WELL REPORT

## Part 2

**Pump Installer's Completion Report**  
 Mississippi Department of Environmental Quality  
 Office of Land and Water Resources  
 P.O. Box 2309  
 Jackson, MS 39225-2309  
 (601)961-5210  
 (601) 360-0535 (fax)

County: <u>QUETMAN</u>
Permit #: <u>GW-49764</u>
Driller: <u>IRRIGATION EQUIPMENT</u>
Date completed: <u>2-2-17</u>
<i>Copy information from block on Part 1</i>

<b>For Office Use Only:</b>
Well #: <u>4161</u>
Aquifer: _____

*This part of the report must be completed by a licensed water well contractor or a licensed pump installer. A copy of Part 1 of the report must be attached and both parts filed with the Department at the above address within 30 days of well completion.*

Well Owner Information	Well Location
Owner Name: <u>ZEPPONE PLANTING CO</u>	Latitude: <u>34° 14' 5.3"</u> Longitude: <u>90° 17' 45.7"</u>
Mailing Address: <u>7 NEIL COVE</u>	Method of Lat/Long (check one): Conventional Survey _____
<u>DUNNELL</u> City	USGS quad _____, Hand-held GPS _____, Survey-grade GPS _____
<u>MS</u> State	<u>SE 1/4 SE 1/4</u> , Sec <u>4</u> T <u>27N</u> R <u>1W</u>
<u>38624</u> Zip Code	<u>1.4</u> Miles <u>SW</u> of <u>MARKS</u>
Telephone No. <u>(662) 627-1377</u>	(Distance) (Direction) (Nearest Town)

Pump Type (circle one)	
<input checked="" type="radio"/> Submersible	Turbine Air Lift Centrifugal Flowing Well Jet Piston Rotary Other (describe): _____
Date Pump Installed: <u>3-1-17</u>	Rated Pump Capacity: <u>2100</u> Gallons Per Minute
Is This Pump (circle one): <input checked="" type="radio"/> New Repaired Replacement	

Power Type (circle one)	
<input checked="" type="radio"/> Electric	Diesel Gasoline Natural Gas Tractor PTO Windmill Other (describe): _____
Horse Power Rating of Motor: <u>60</u>	Setting Depth: <u>20</u> feet Number of Stages: <u>1</u>

Pump Test Data for Non Flowing Well	
Date Well Tested: _____	Duration of Pump Test (minimum 4 hours): _____ hours
Static Water Level (A): <u>25</u> Feet Below Land Surface	Pumping Water Level (B): _____ Feet Below Land Surface
Drawdown [(B) - (A)]: _____ Feet Below Land Surface	Test Pumping Rate: _____ Gallons Per Minute
Method of measurement (circle one): Steel tape Electric tape Air line Other (describe): _____	

Pump Test Data for Flowing Well	
Measured shut in head: _____ feet.	
Well yielded _____ GPM with a drawdown of _____ feet after _____ hours of pumping	


Meter Installation	
Meter Manufacturer: _____	Meter Serial Number: _____
Meter Model Number/Name: _____	Type of Meter: _____
Totalizer Register Unit and Multiplier Factor (AF x .001, gal x 1000, etc): _____	
Installation Date: _____	Meter installed by: _____
Is This Meter (circle one): New Repaired Replacement	
<i>Important: By submitting the above information you are certifying that this meter was installed to manufacturer standards. For agricultural wells, a list of approved meters is on the MDEQ website.</i>	

I HEREBY CERTIFY that the above statements are true to the best of my knowledge.	
<u>DAVID P. HOLT 0-752P</u>	<u>3-25-17</u>
Print Name of Pump Installer and License No. (if applicable)	Date
	Signature of Pump Installer

Form: OLWR-SWR-1B (4/13)

16-1091

H161

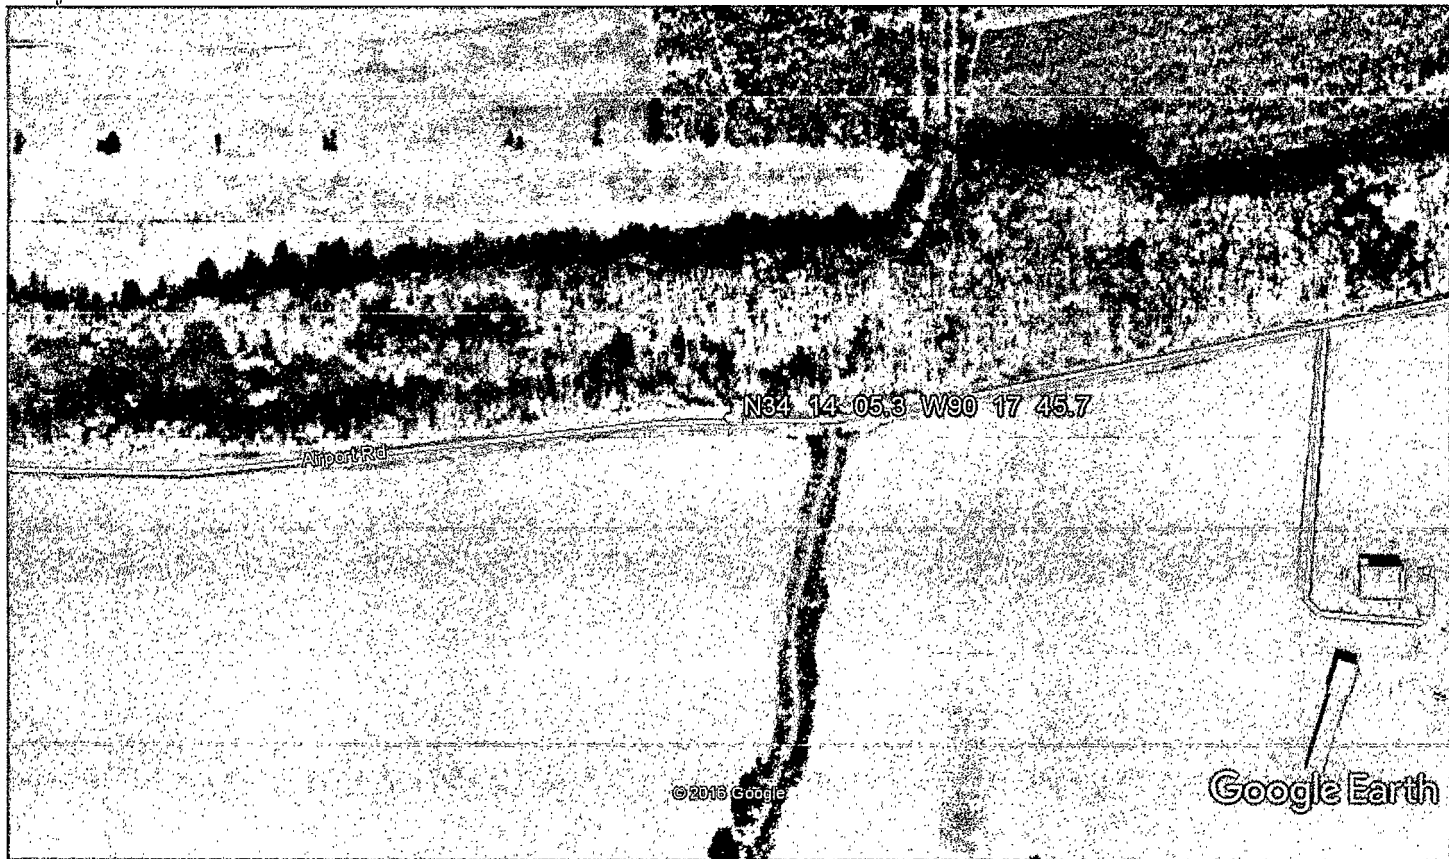

Google Earth



RECEIVED  
FEB 14 2017  
BY OLWR

H161

**STATE OF MISSISSIPPI**  
**Department of Environmental Quality**  
**Office of Land and Water Resources**  
**P. O. Box 2309**  
**Jackson, Mississippi 39225**

**PERMIT**

**TO DIVERT OR WITHDRAW FOR BENEFICIAL USE THE PUBLIC WATERS**

This permit is issued to the landowner named below in accordance with the provisions of the Mississippi Water Laws, Mississippi Code Sections 51-3-1, et seq. (1972, as amended), and the regulations and standards as promulgated thereunder. Whether or not specifically named in this permit or in the applications for this permit, anyone using water from the diversion/withdrawal point described below shall do so in compliance with the provisions of this permit. Neither this permit, nor any authority conferred hereby, may be sold, conveyed, encumbered, assigned, or otherwise aliened, for any period of time or under any conditions whatsoever. This permit may not be modified, transferred or revoked without prior action by the Permit Board. Any attempts to modify, transfer or revoke this permit, or to take any other action on this permit, shall be invalid and unenforceable and may result in immediate revocation or suspension of this permit. The holder of this permit shall at all times be responsible for adherence to the terms and conditions of this permit. No agreement between the permit holder and any other party shall affect the obligations and liabilities of the permit holder. Water use under this permit is allowed only when the streamflow, lake level elevation, or static groundwater level (whichever, if any, is applicable) is above the established minimum, pursuant to Mississippi Code Section 51-3-7. Authorization is hereby granted to divert/withdraw water for the beneficial use designated herein, and for no other purpose, subject to the following terms, conditions, and limitations:

**Permit Number:** MS-GW-49764

**Landowner Name:** ZEPPONI PLANTING COMPANY

**Landowner Address:** 7 NEIL COVE  
DUNDEE MS 38626

**Source Of Water:** MISSISSIPPI RIVER VALLEY ALLUVIAL AQUIFER

**Beneficial Use:** IRRIGATION

**Diversion/Withdrawal Location:** SE 1/4 of the SE 1/4 **Section:** 04 **Township:** 27N **Range:** 01W

**County:** QUITMAN

**Quad:** LAMBERT

**Maximum Volume:** 318 Acre-Feet/Year *equivalent to* .2838 Million Gallons/Day

**Maximum Rate:** 2100 Gallons/Minute

**Applicant Name:** ZEPPONI PLANTING COMPANY

**Applicant Address:** 7 NEIL COVE  
DUNDEE MS 38626

**Date Permit Issued:** 12/15/2016

**Date Permit Expires:** 12/15/2021

**Date Permit Modified:**

**Date Permit Re-issued:**

This permit shall be deemed null and void if construction has not begun within one (1) year of permit issue date

**SPECIAL TERMS AND CONDITIONS:** SEE ATTACHMENT 1, WHICH IS HEREBY DECLARED TO BE PART OF THIS PERMIT.

**SPECIAL TERMS AND CONDITIONS 2:**

RECEIVED  
FEB 14 2017  
BY OLWR

Gary C. Rikard, Executive Director  
Mississippi Department of Environmental Quality