

QUITMAN  
H 2000  
10-21-80

MISSISSIPPI  
BOARD OF WATER COMMISSIONERS  
416 North State Street  
Jackson, Mississippi 39201

WATER WELL DRILLERS LOG

10-21-80 date well completed  
Hicksville Co. firm name  
Quitman county well located

LANDOWNER: <u>Butch Hawkins</u>	description of formations encountered	from	to
<u>Mark, Mo</u> (mailing address)	<u>Black Clay</u>	0	15
WELL LOCATION:	<u>white sand</u>	15	60
sec. <u>6</u> T <u>27</u> N R <u>1</u> E <u>6</u> miles <u>SW</u> of <u>Marko</u> (distance) (direction) (nearest town)			
WELL PURPOSE: <u>Home</u> (home, irrigation, municipal, industrial)			
WELL COMPLETION DATA:			
(1) diameter (inches) <u>4</u>			
(2) total depth (feet) <u>60</u>			
(3) static water level (feet) <u>20</u> below top of ground.			
(4) casing <u>PVC</u> , <u>20</u> (material) (depth)  (size) If telescope see back.			
(5) screen <u>10</u> , <u>10</u> (length) (depth to top)			
<u>4"</u> , <u>slotted</u> (size) (material)			
(6) pump <u>1</u> , <u>18</u> (HP) (yield gpm)  <u>220V</u> (type power)			
(7) electric log <u>No</u> (yes or no)			
(organization running log)			
(8) how well bottom plugged <u>Cap</u>			
DRILLERS REMARKS:			


DEPT. OF NATURAL RESOURCES  
BUREAU OF LAND & WATER RESOURCES

OCT 29 1980

RECEIVED

If well telescopes please sketch and show depths.

GROUND LEVEL

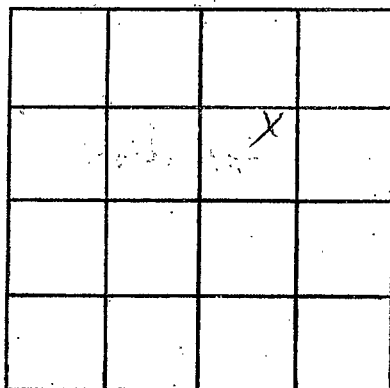

SECTION 6

Please indicate well location X.

ADDITIONAL INFORMATION

If more than one screen,  
show locations of each on sketch.